
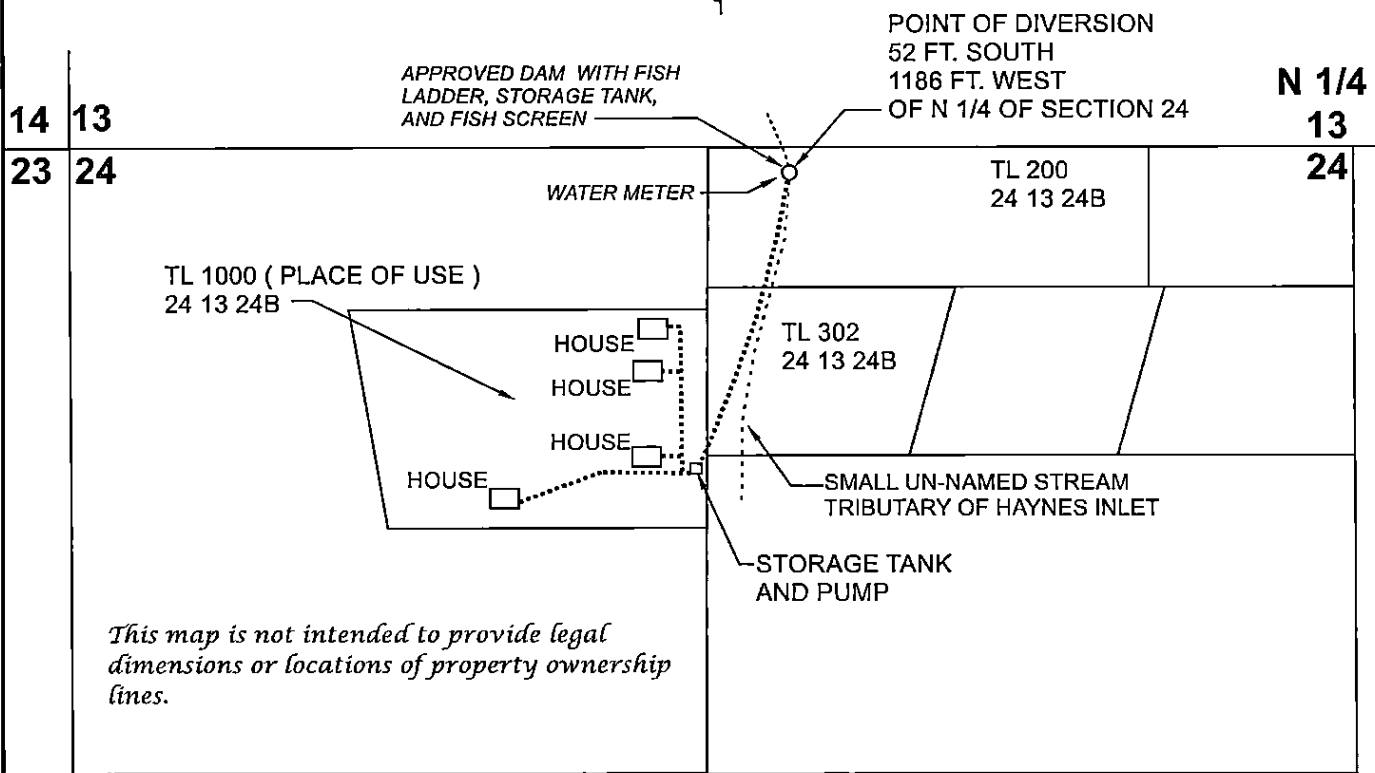


T. 24 S., R 13 W., W.M.

LEGEND

- SECTION AND PROPERTY BOUNDARIES
- 1" WATER LINE
- UN-NAMED STREAM

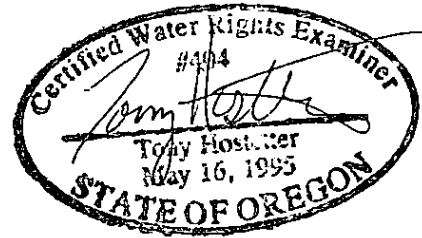

POINT OF DIVERSION
DIV. PT. LOCATED 52 FT. SOUTH & 1186 FT WEST,
FROM THE N 1/4 CORNER OF SECTION 13

SCALE: 1"=400'

FINAL PROOF SURVEY

UNDER

Application No. S-80522 Permit No. S-53447
IN THE NAME OF

GLENDEN R. AND MARY L. POUNDS

Surveyed March 14, 2014, by T.HOSTETTER

Revised: 3/14/18

RECEIVED

MAR 16 2018

OWRD