


T11S, R4W, W.M.
T11S, R5W, W.M.

CLAIM OF BENEFICIAL USE MAP

IN THE NAME OF

PINOT GRIS WATER COMPANY

Application G-15311 Permit G-17087
Permit Amendment T-11625

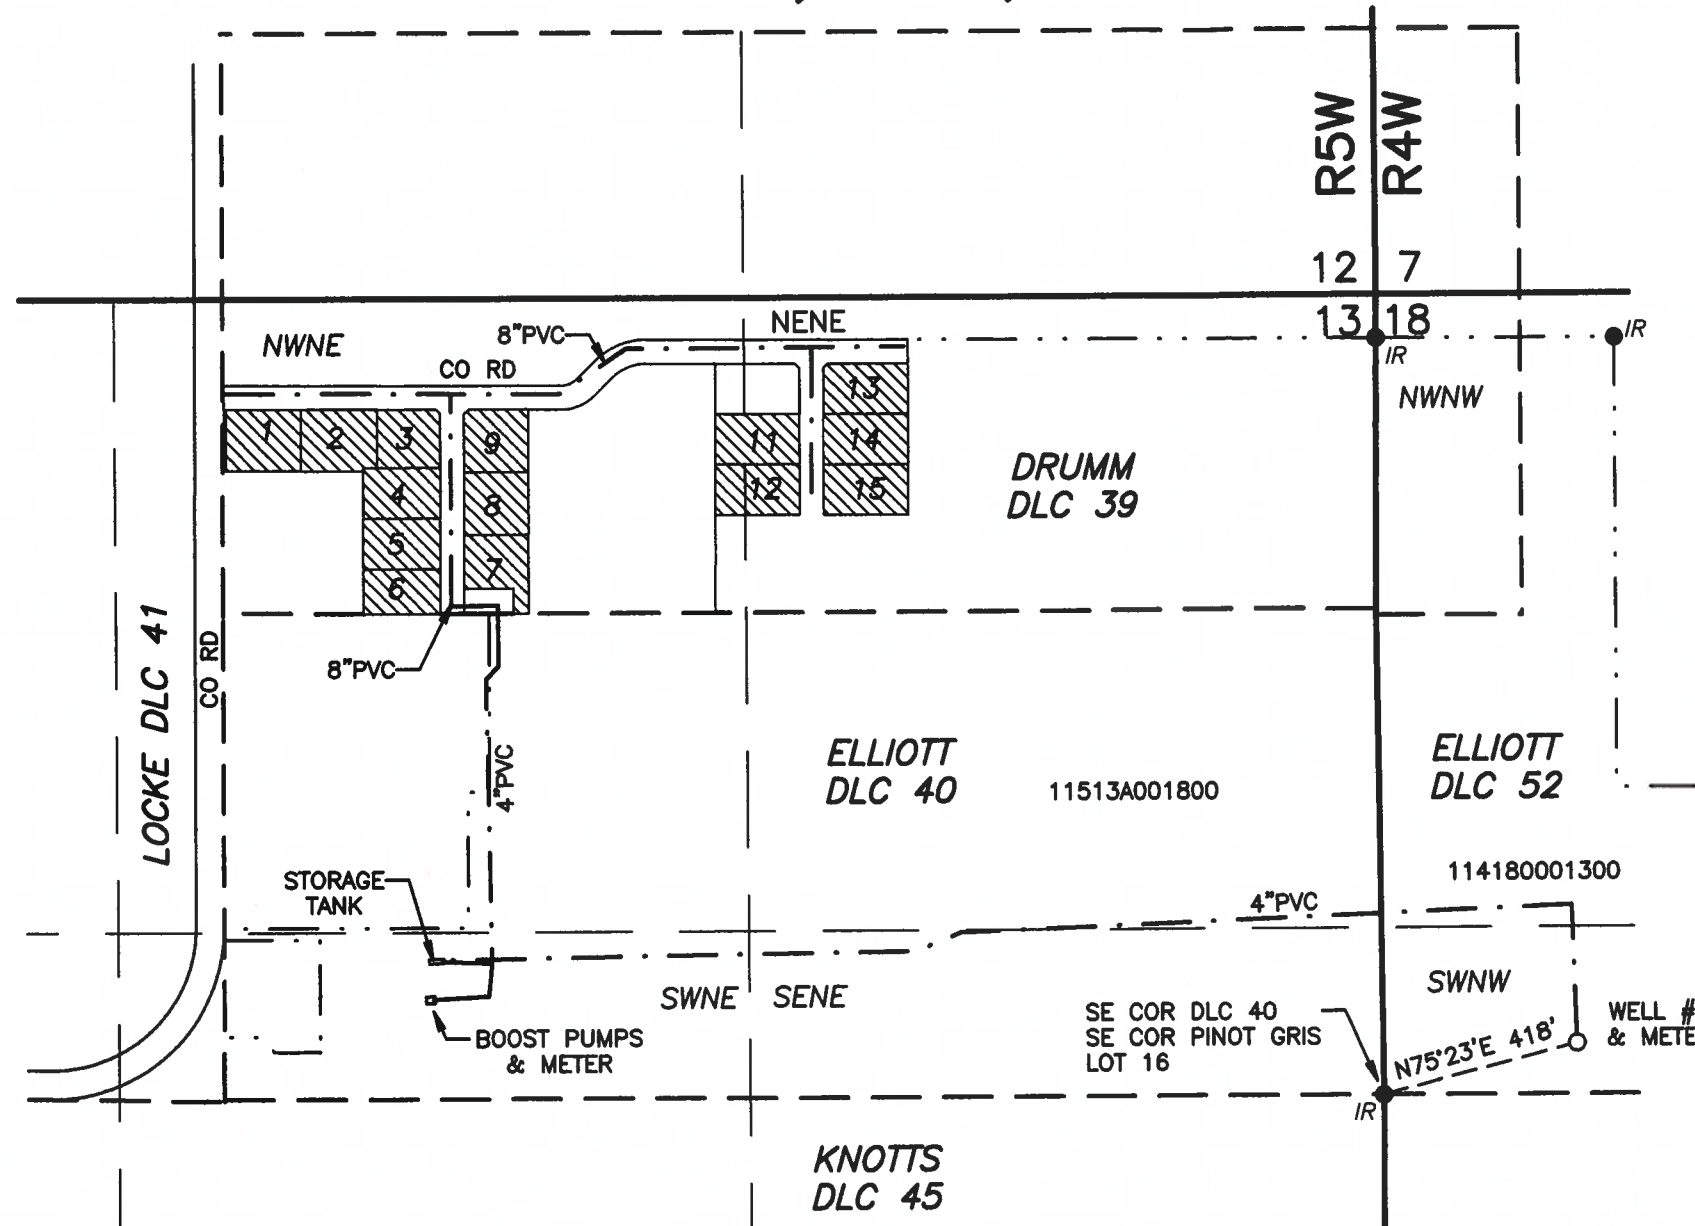

PINOT GRIS ESTATES
MAP 11-5-13AB

LOT	TAX LOT
1	0100
2	0200
3	0300
4	0400
5	0500
6	0600
7	0700
8	0800
9	0900
11	1200
12	1300
13	1600
14	1500
15	1400

LOT SIZES
0.36 AC - 0.46 AC




1" = 400'

RECEIVED BY OWRD

MAR 10 2014


SALEM, OR

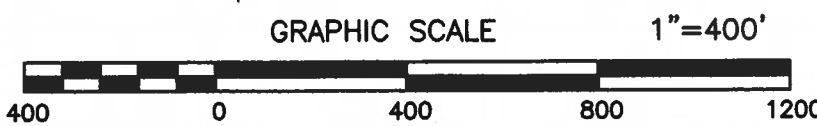

LEGEND
 - - - - - PROPERTY LINE
 - WATER LINE
 [Hatched Box] PLACE OF USE, PINOT GRIS ESTATES

WELL #1 - NORTH 106 FT AND EAST 404 FT (N75°23'E 418 FT) FROM THE SE CORNER, ELLIOTT DLC 40, T10S, R5W, W.M.

THIS MAP IS NOT INTENDED TO PROVIDE LEGAL DIMENSIONS OR LOCATIONS OF PROPERTY OWNERSHIP LINES

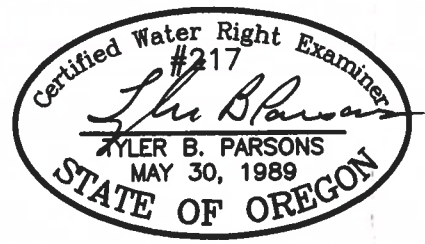

RENEWS: 12/31/2014

Prepared: March 4, 2014
PARSONS SURVEYING
1915 SE Stone St.
Corvallis, OR 97333
541-752-7515
Project No. 1027