

SECTION 25, T.2N., R.3W., W.M.
WASHINGTON COUNTY, OREGON

RECEIVED


MAY - 6 1994


WATER RESOURCES DIVISION
SALEM, OREGON

N

SCALE: 1"=400'

MAP BASE:
WASHINGTON COUNTY ASSESSORS MAP
WAC 1993 PHOTO

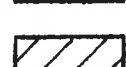	A	G-12208	
	P	G-11187	Irrigation
	P	R-47383, 31473	Supplemental
	C	40484, 40485	Irrigation

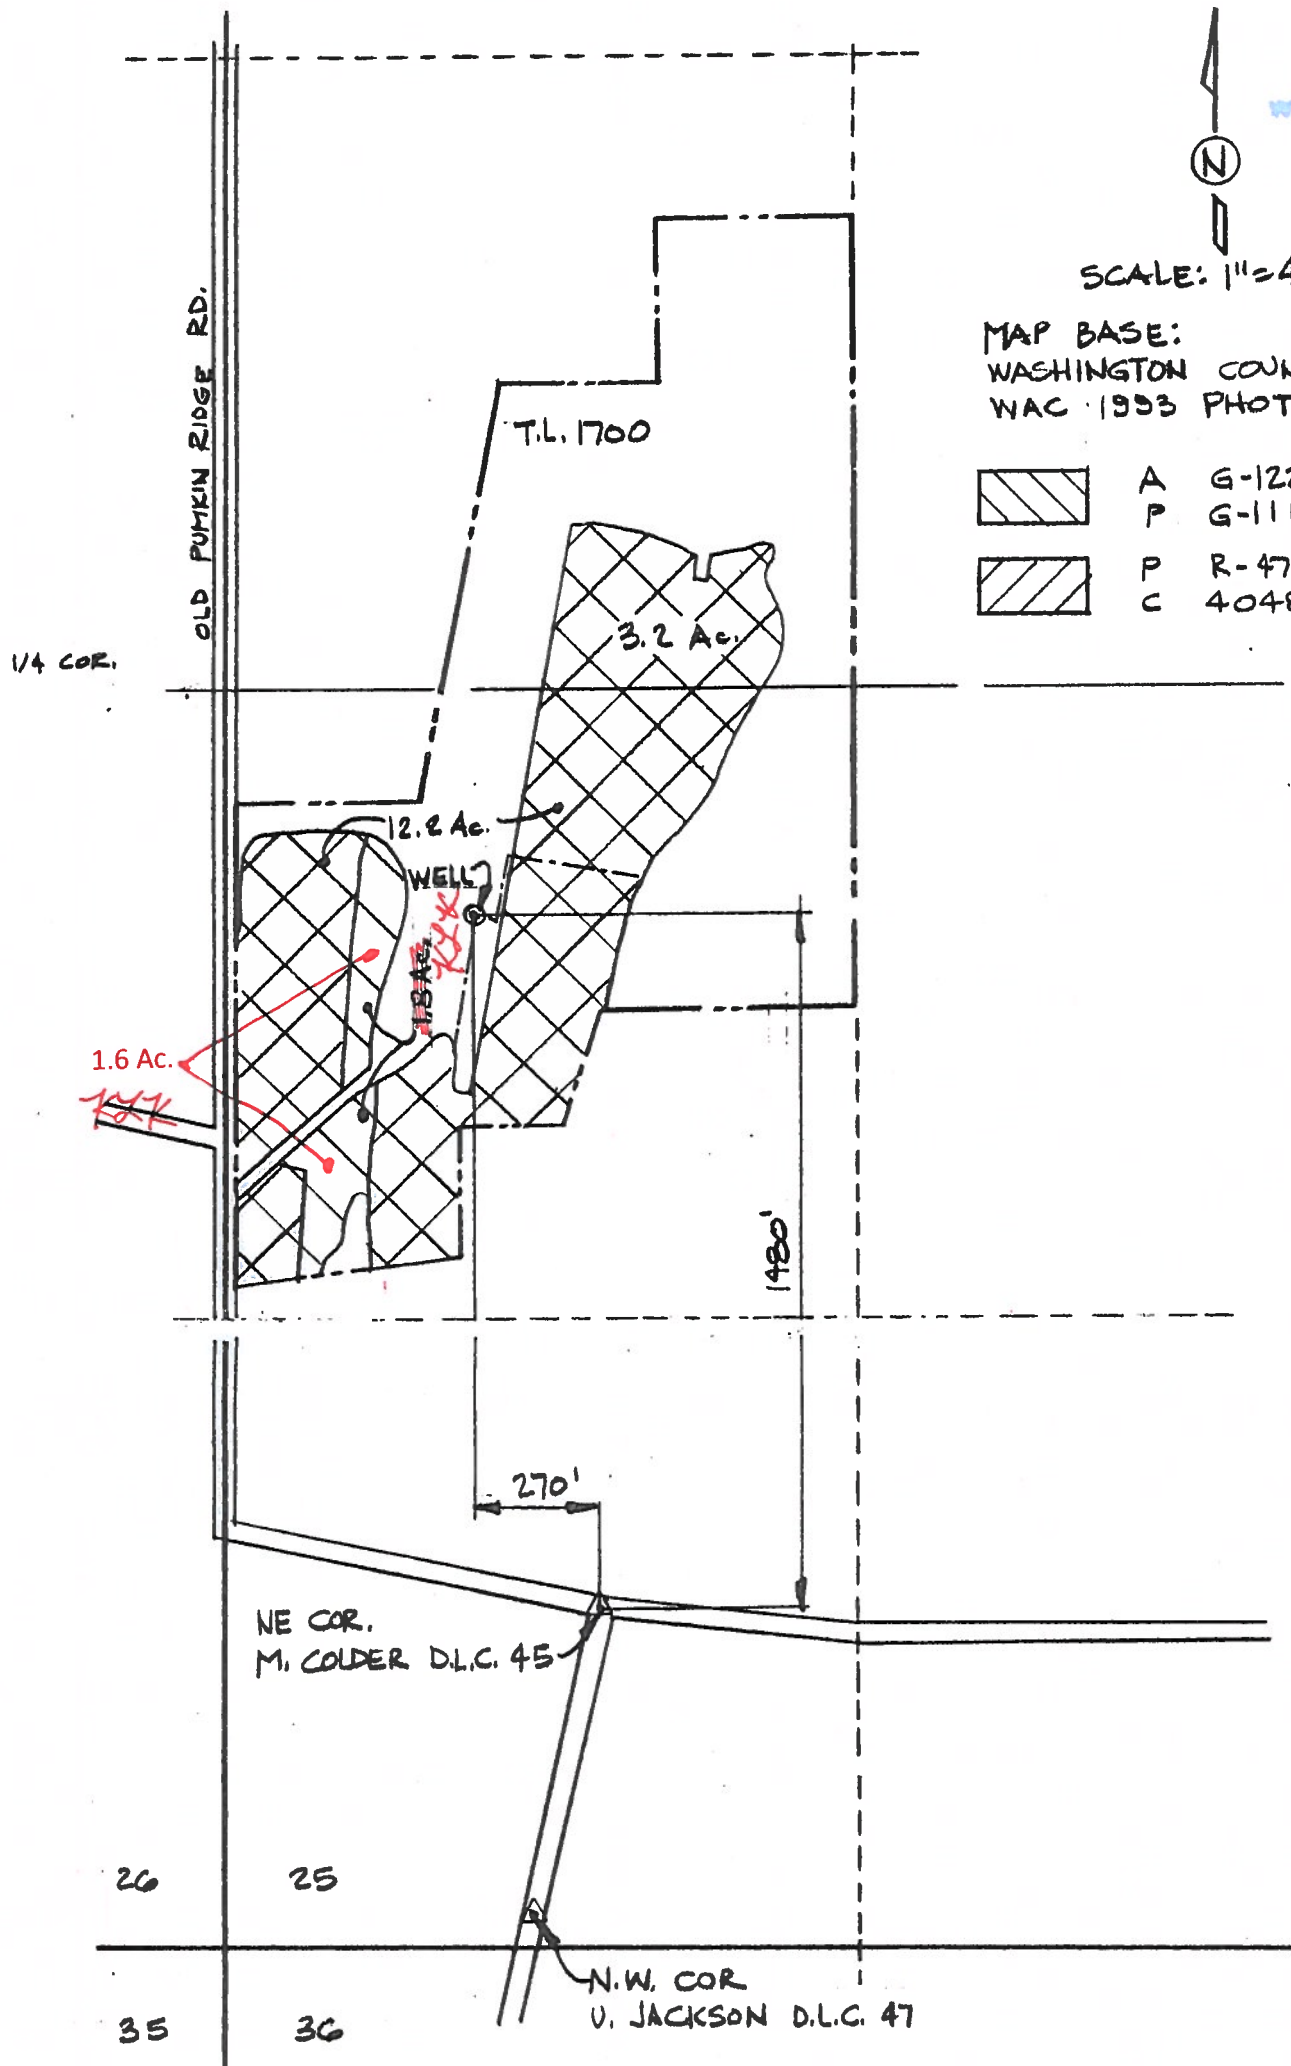

FINAL PROOF SURVEY

UNDER
PERMIT G-11187, SURVEYED 1/20/94

WRD has updated this map to reflect the correct acres as clarified by James Wood,
received 3/1/18, being 1.6 acres irrigation and 15.4 acres supplemental irrigation.
KLK/WRD 3/5/2018 *KLK*

PREPARATION OF THIS MAP IS FOR THE
PURPOSE OF IDENTIFYING THE LOCATION OF
THE WATER RIGHT ONLY. THERE IS NO INTENT
TO PROVIDE DIMENSIONS OR LOCATION OF
PROPERTY OWNERSHIP LINES.

VERBOORT ENGINEERING
AGRICULTURE • CIVIL • WATER RESOURCES
HILLSBORO, OREGON

designed WRV 4.22.94
drawn JER 4.22.94
checked WRV 4.22.94
drawing no. 94-B-10
sheet no. 1/1

JAMES A. & JOANNE WOOD
P.O. BOX 5
NORTH PLAINS, OR

