


TOWNSHIP 17 SOUTH, RANGES 21 & 22 EAST, W.M.

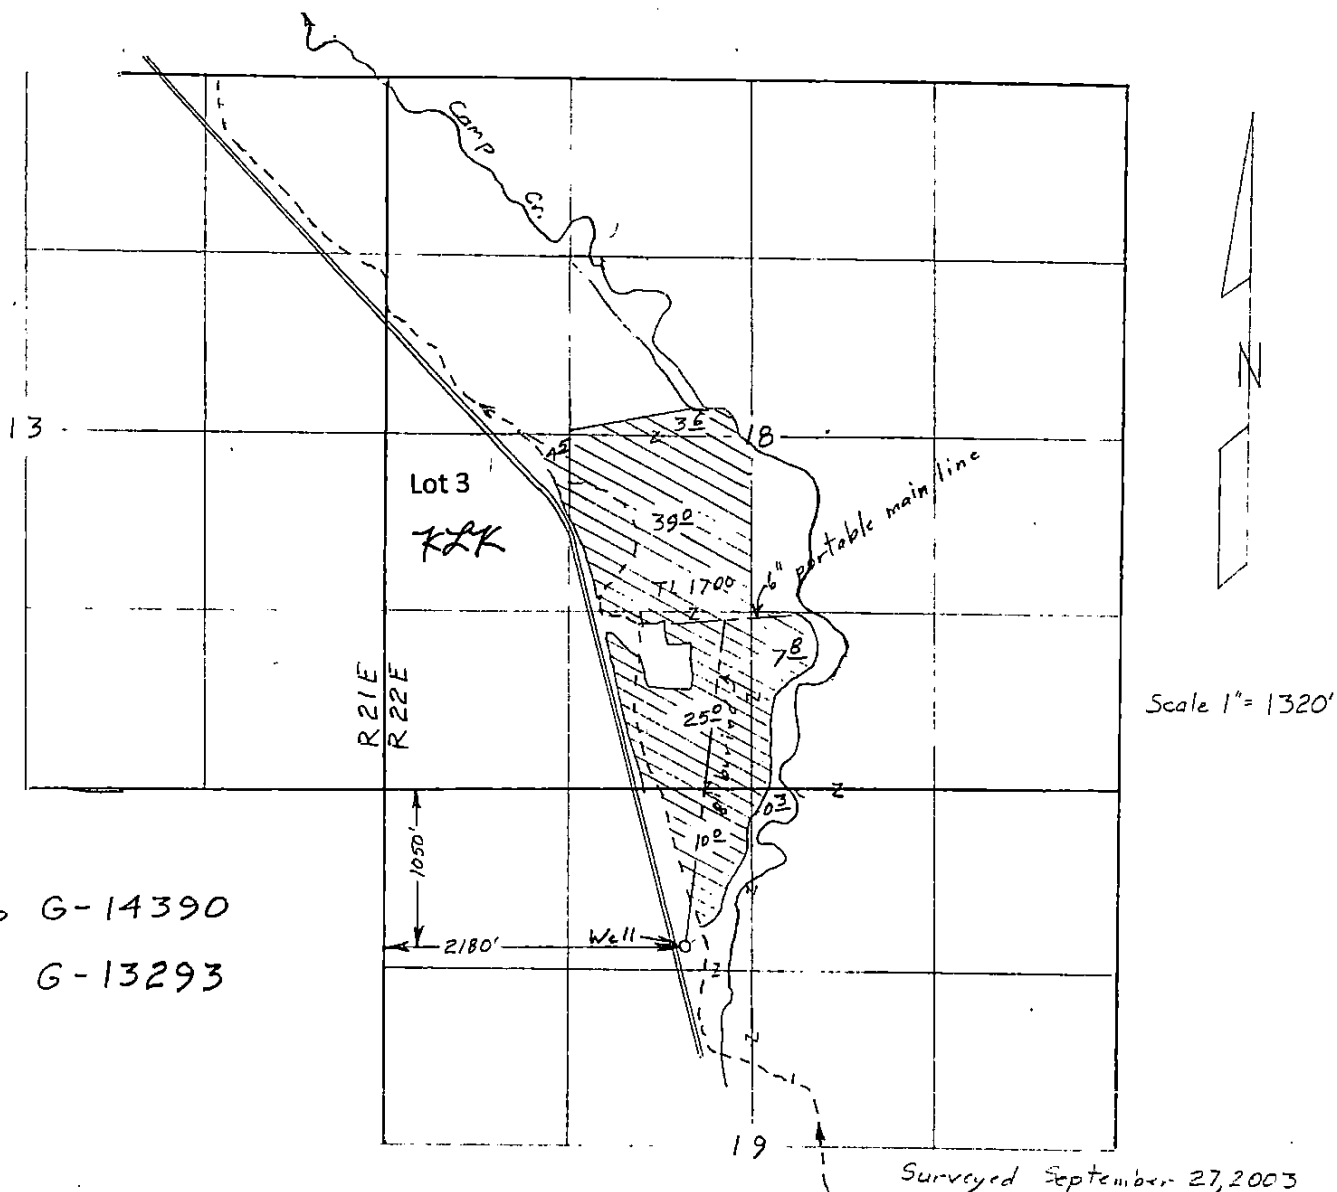

App G-14390

Per G-13293


Claim of Beneficial Use Map
for

LS RANCH

WRD has updated this map to reflect
Government Lots based on Cadastral
Survey of Township 17 South,
Range 22 East, W.M. dated 05-07-1872.

WRD/KLK 3/7/2018

KLK

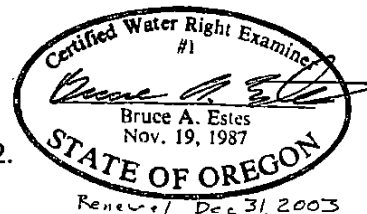

RECEIVED

FEB 05 2003

WATER RESOURCES DEPT
SALEM OREGON

This map is for the purpose of
locating a water right only
and has no intent to provide
legal dimensions or the location
of property lines.

ESTES SURVEYS, LLC
6293 Sunnyview Rd. NE 60382 Arnold Rd.
Salem, OR 97305 Bend, OR 97702
(503) 585-7593 (503) 382-7391