


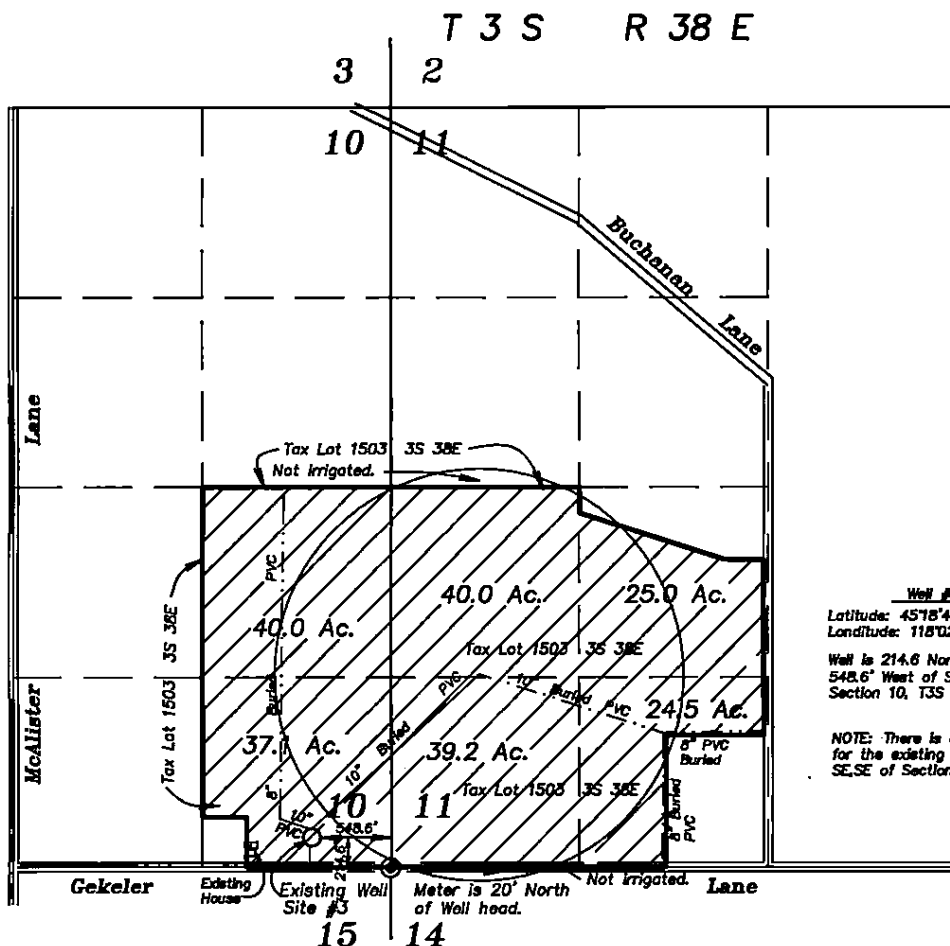

SCALE: 1"=1320'

Well # 3
Latitude: 45°18'42.47656" N
Longitude: 118°02'13.28773" W

Well is 214.6 North and
548.6 West of SE Corner of
Section 10, T3S R38E, WM

NOTE: There is a 0.1 acre deduction
for the existing dwelling within the
SE/SE of Section 10.


 Lands with Primary Surface Water Rights
Certificate #6368, Source being Springs and
Sloughs, and Grande Ronde River now being
irrigated with Supplemental water from Well # 3.

Existing Well site #3 is located 1393'
East and 60' North of the Southwest
corner of Section 11. Wells at Site # 1
and site # 2 were not drilled.

RECEIVED BY OWRD

OCT 16 2014

SALEM, OR

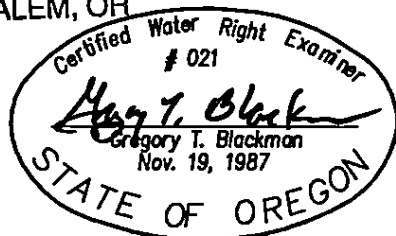

September 17, 2003

**CLAIM OF BENEFICIAL USE MAP
FOR IRRIGATION UNDER G-15684
FROM WELL # 3**

FOR
THOMAS M. BOWMAN AND
DELIA BOWMAN
BY

BAGETT - GRIFFITH & BLACKMAN
2006 ADAMS AVENUE
LAGRANDE, OREGON 97850

APPLICATION NO. G-16091

PERMIT NUMBER G-15684

NOTE: The preparation of this map
was for the purpose of identifying
the location of the proposed water
right and has no intent to provide
dimensions or location of property
ownership lines. Location information
shown hereon was furnished by
the applicant.