




R 8 W | R 7 W

T 28 S
T 29 S

T 28 S
T 29 S

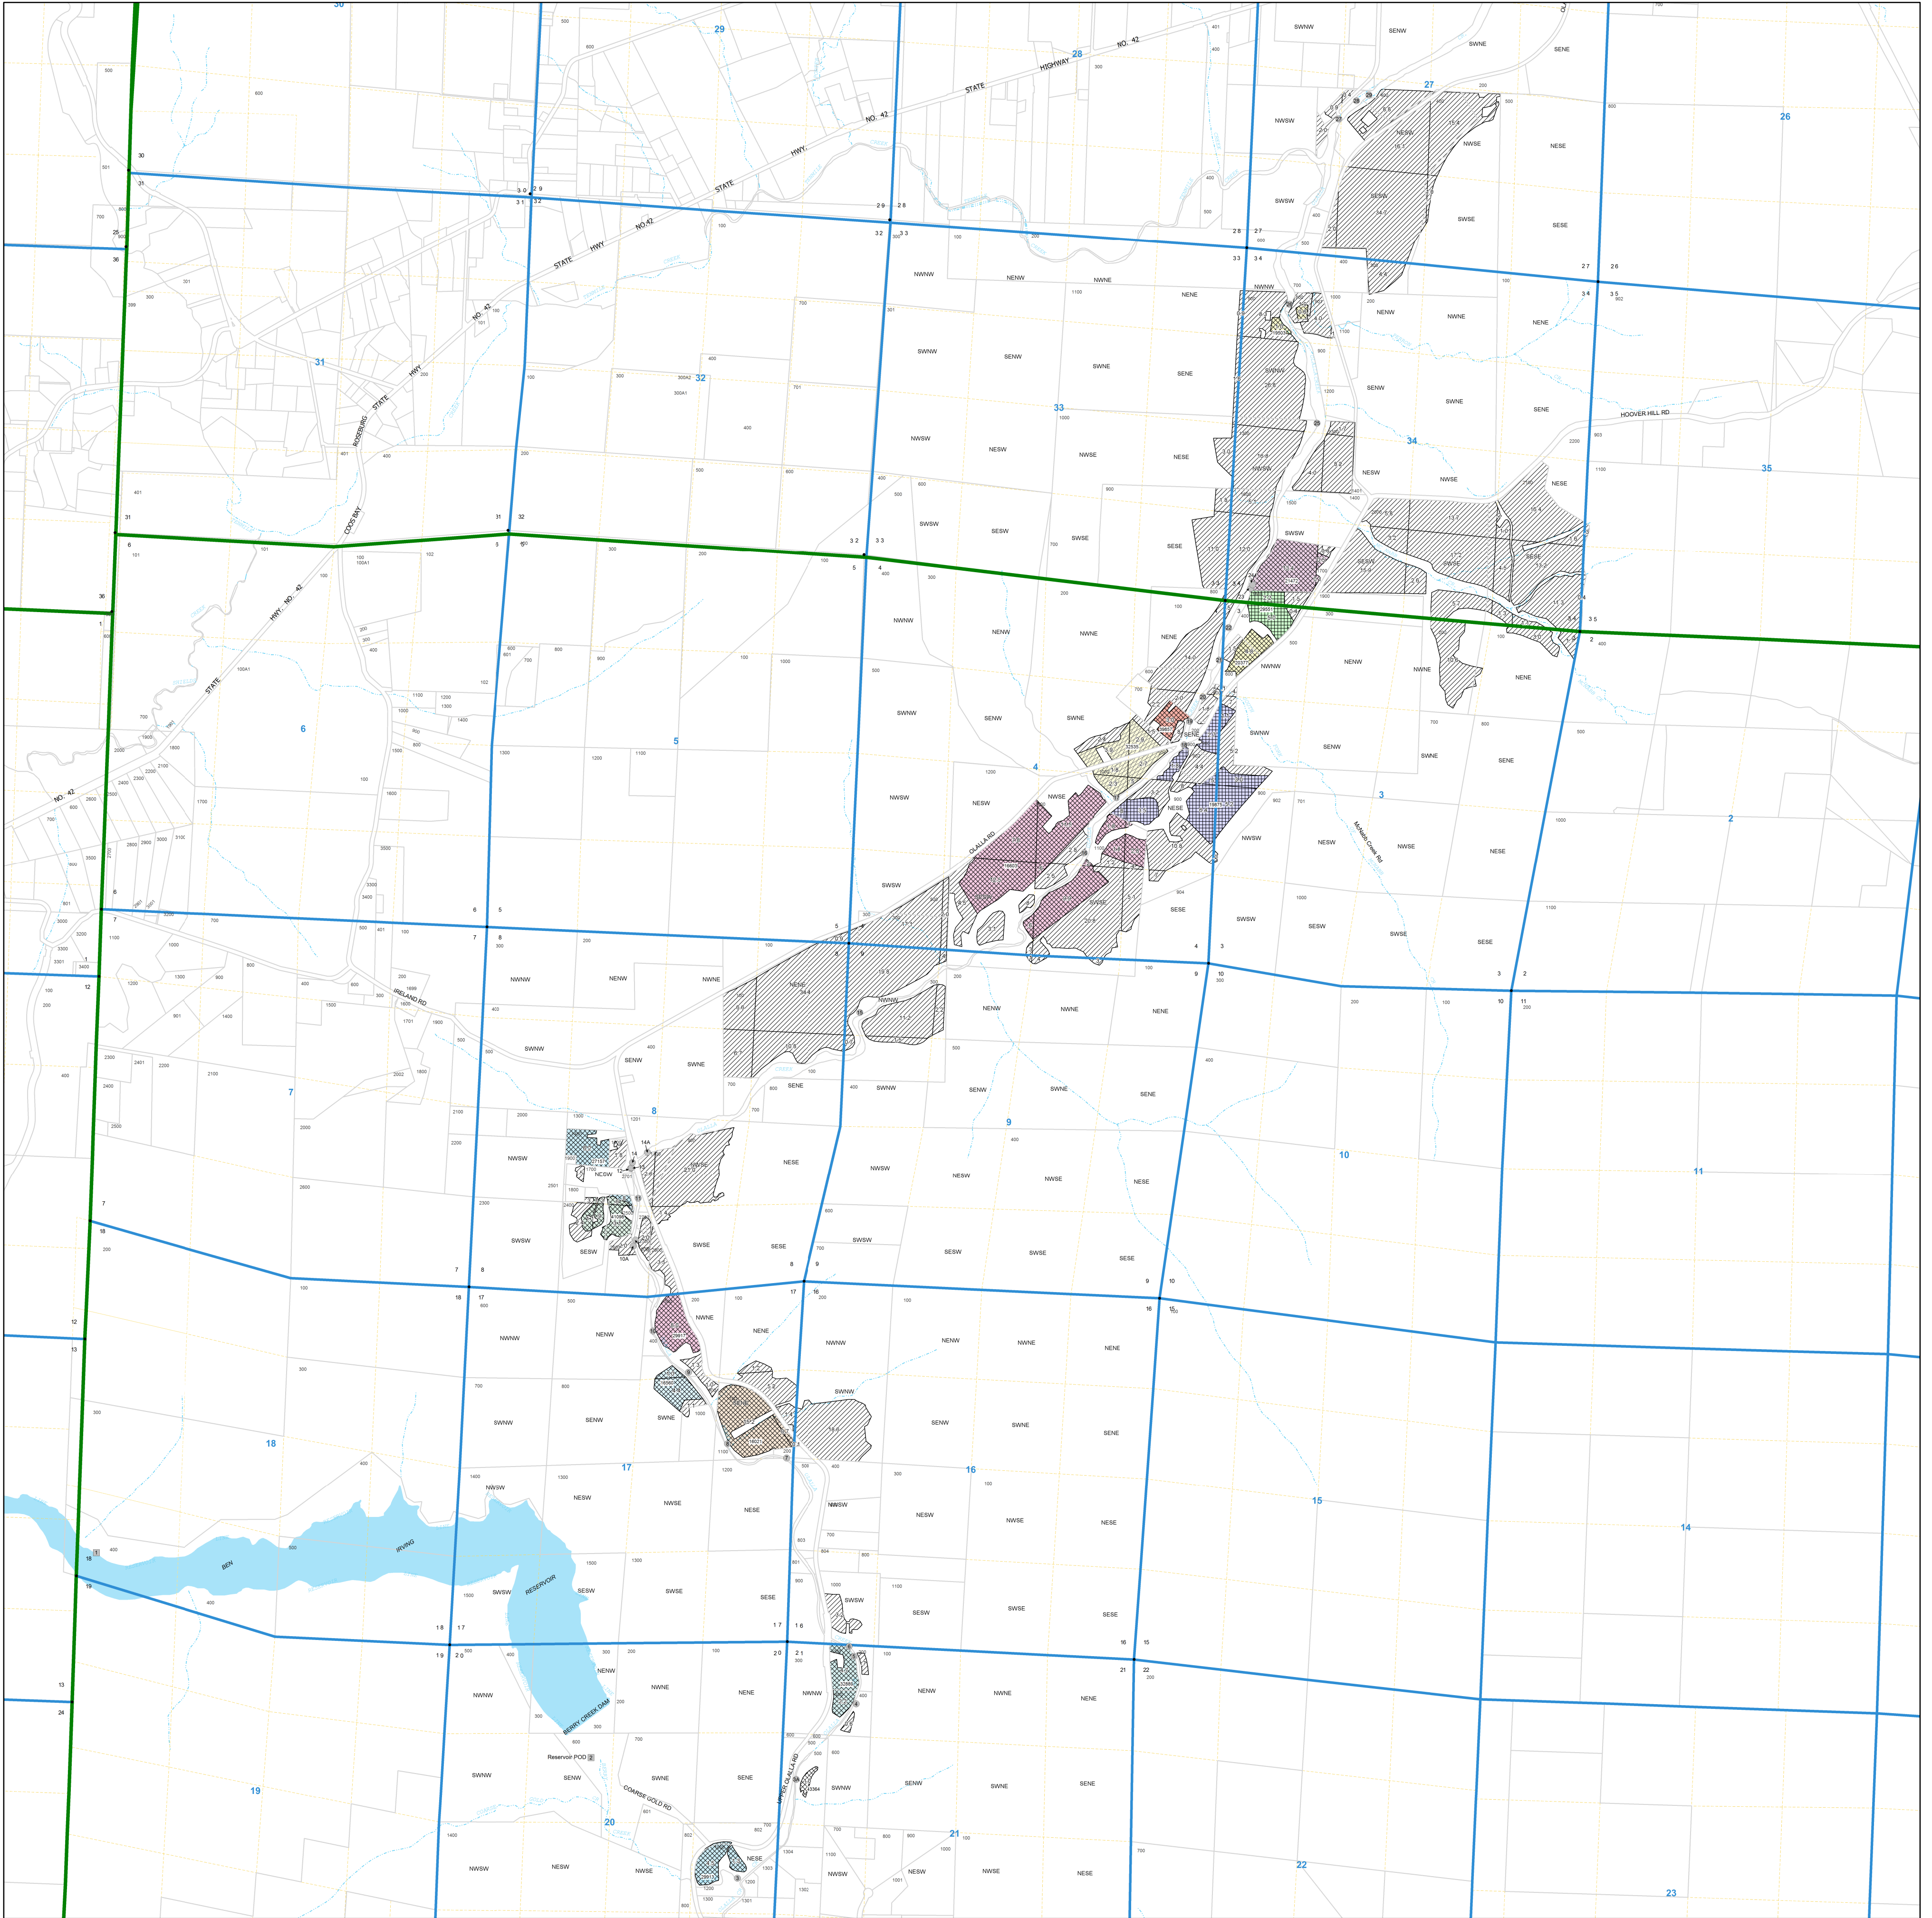

R 8 W | R 7 W

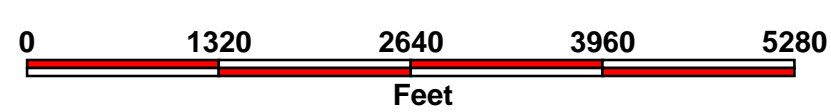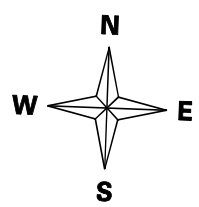

1"=1320'

Final Proof Survey Map

Application 59900 Permit 46786

Lookingglass - Olalla Water Control District

Douglas County, Oregon

Legend

- RePoint Of Diversion
- Point Of Diversion
- QuarterQuarter
- Streams
- Supplemental Stored Water Right
- Primary Stored Water Right
- Parcels
- Section
- Township
- Reservoir
- 29551 Live Flow Permit Number

This map is not intended to provide legal dimensions or location of property lines.


The information used to prepare these maps is derived from a site visit to all of the Points of diversion and Re-division in the District, between May of 2014 and January of 2016. Additional data was gleaned from Douglas County Assessor's Maps, maps and water right information from the Surveyors office and aerial photographs from Google Earth. Finally, the Lookingglass Olalla Water Control District provided maps, water right information, water purchase contracts and water use accounting.

R 7 W

R 6 W



T 27 S

T 28 S

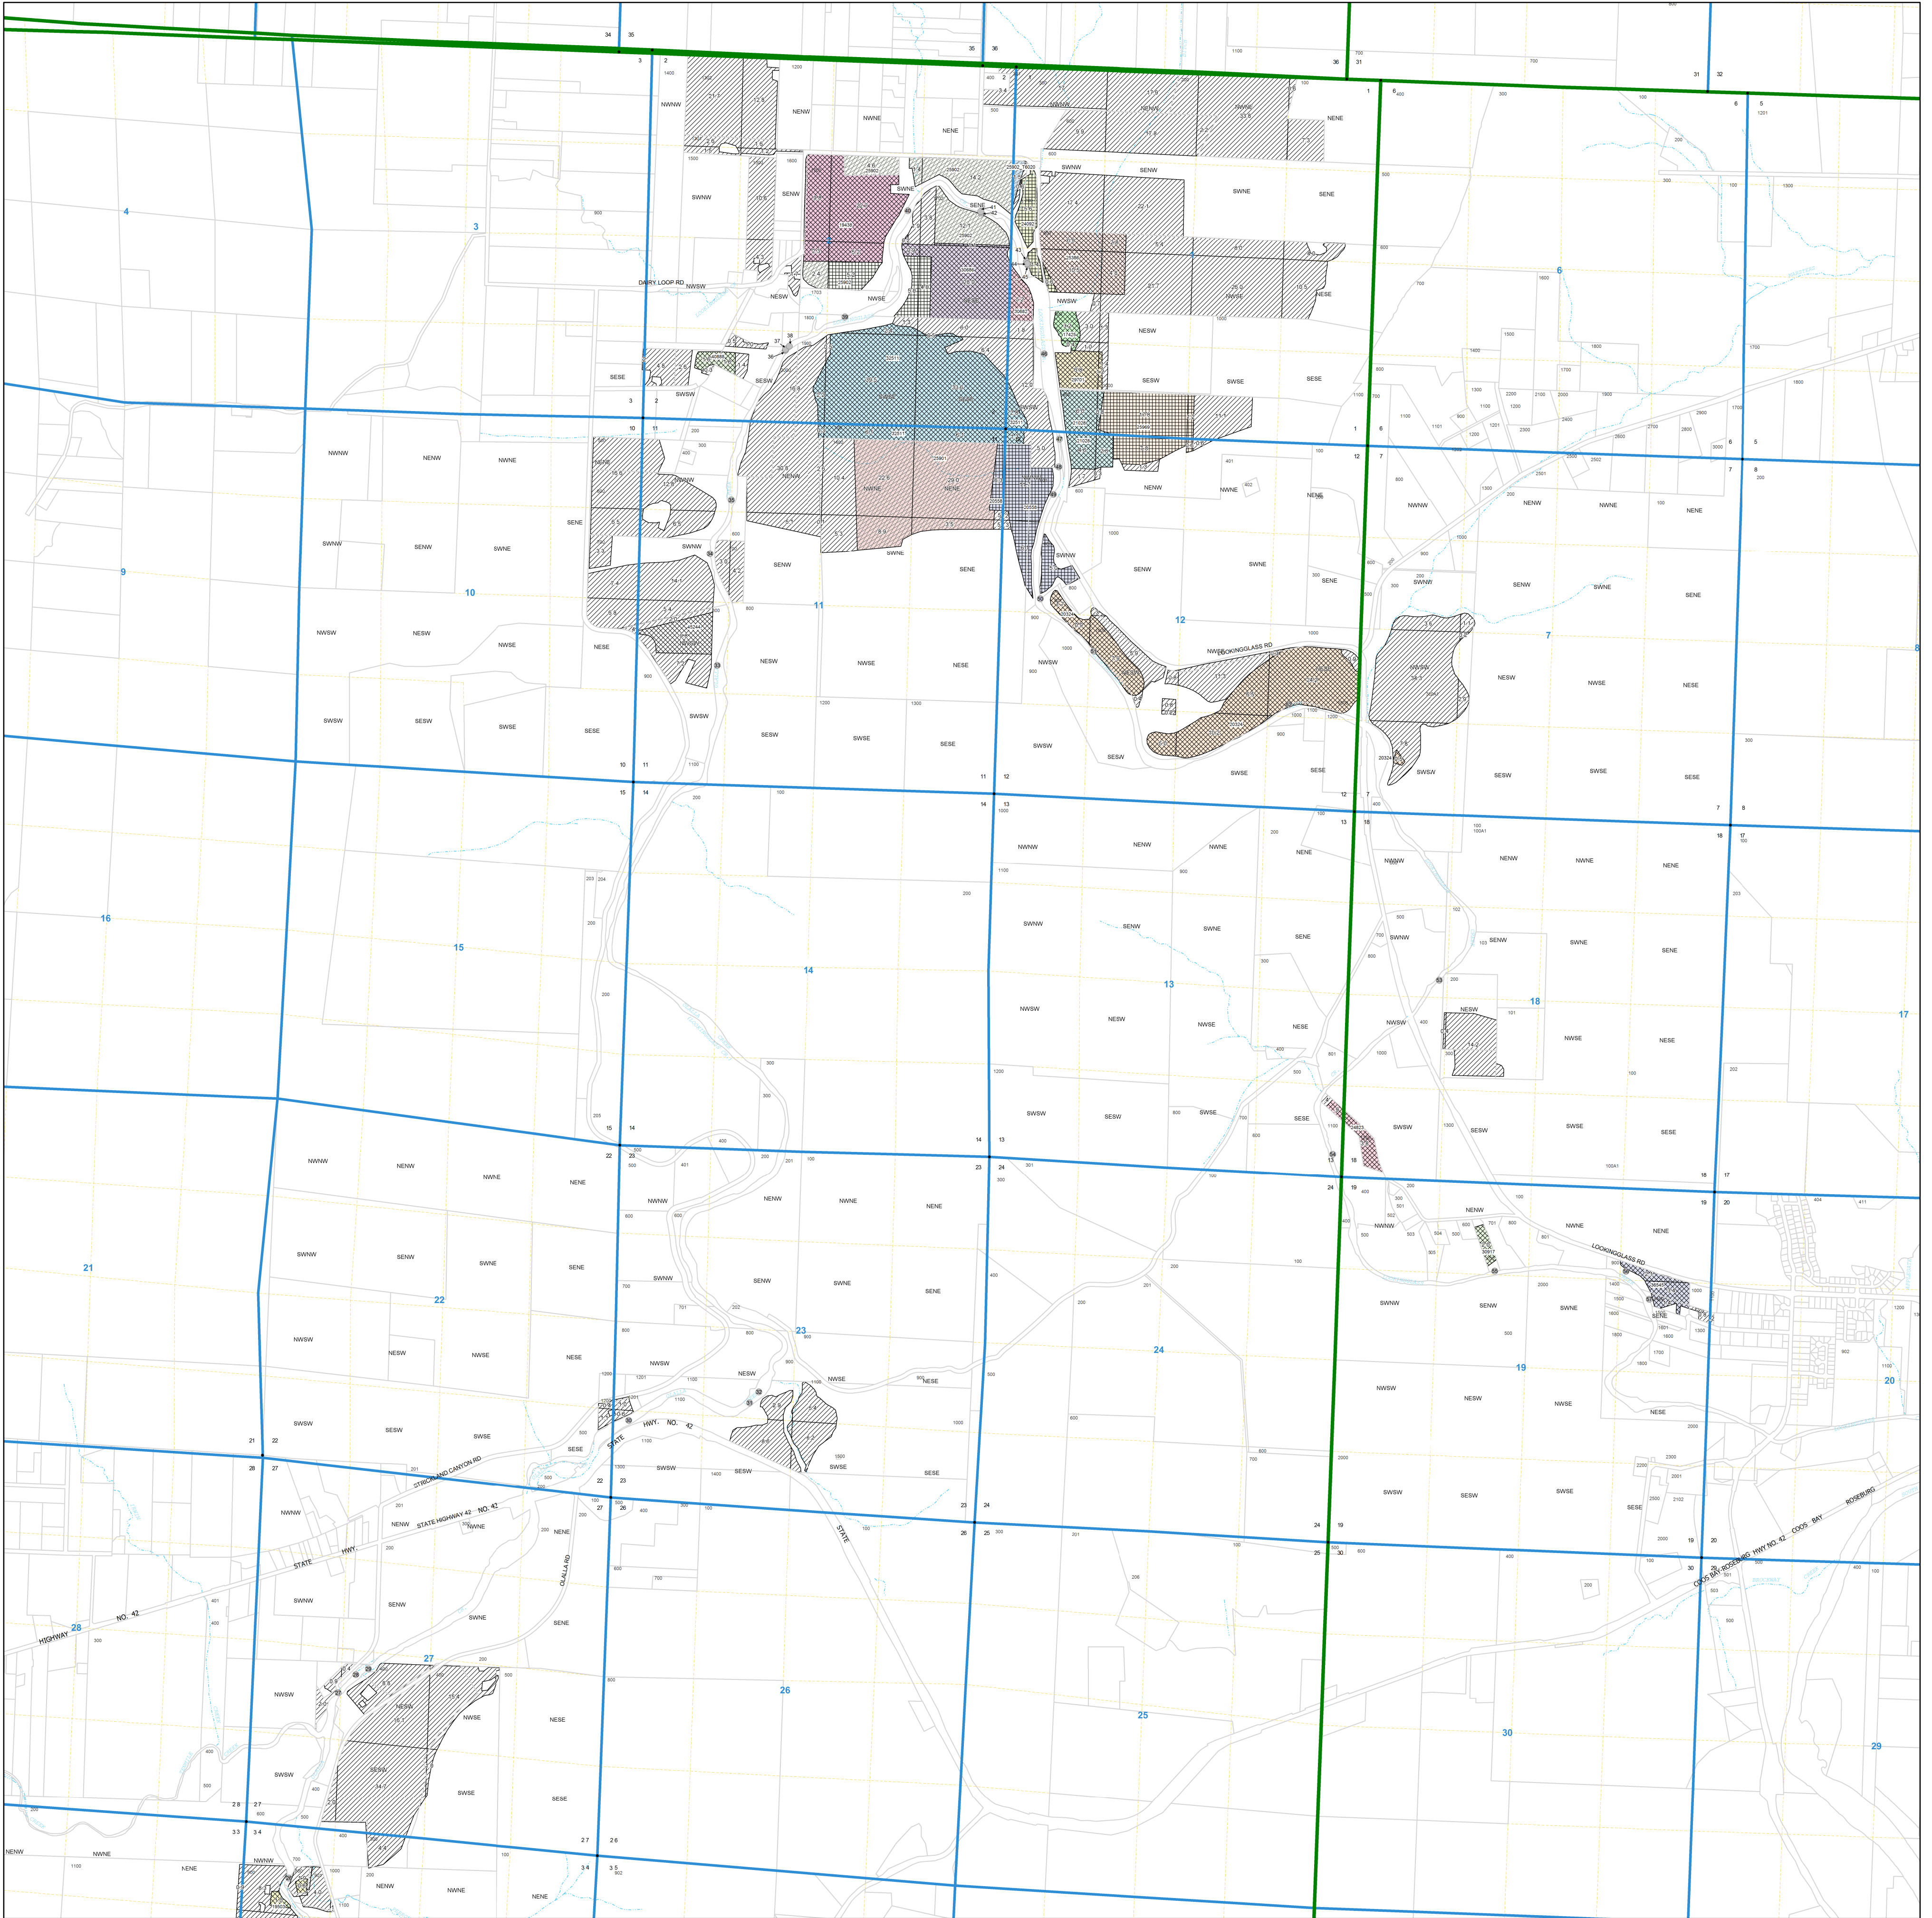

R 7 W

R 6 W

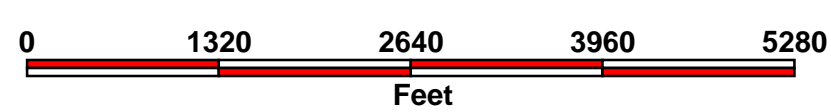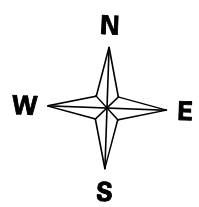

1"=1320'

Final Proof Survey Map

Application 59900 Permit 46786

Lookingglass - Olalla Water Control District

Douglas County, Oregon

Legend

- RePoint Of Diversion
- Point Of Diversion
- QuarterQuarter
- Streams
- Supplemental Stored Water Right
- Primary Stored Water Right
- Parcels
- Section
- Township
- Reservoir
- 29551 Live Flow Permit Number

This map is not intended to provide legal dimensions or location of property lines.

The information used to prepare these maps is derived from a site visit to all of the Points of diversion and Re-diversion in the District, between May of 2014 and January of 2016. Additional data was gleaned from Douglas County Assessor's Maps, maps and water right information from the Surveyors office and aerial photographs from Google Earth. Finally, the Lookingglass Olalla Water Control District provided maps, water right information, water purchase contracts and water use accounting.