


EXHIBIT B

T24S, R36E, W.M.
Harney County, Oregon

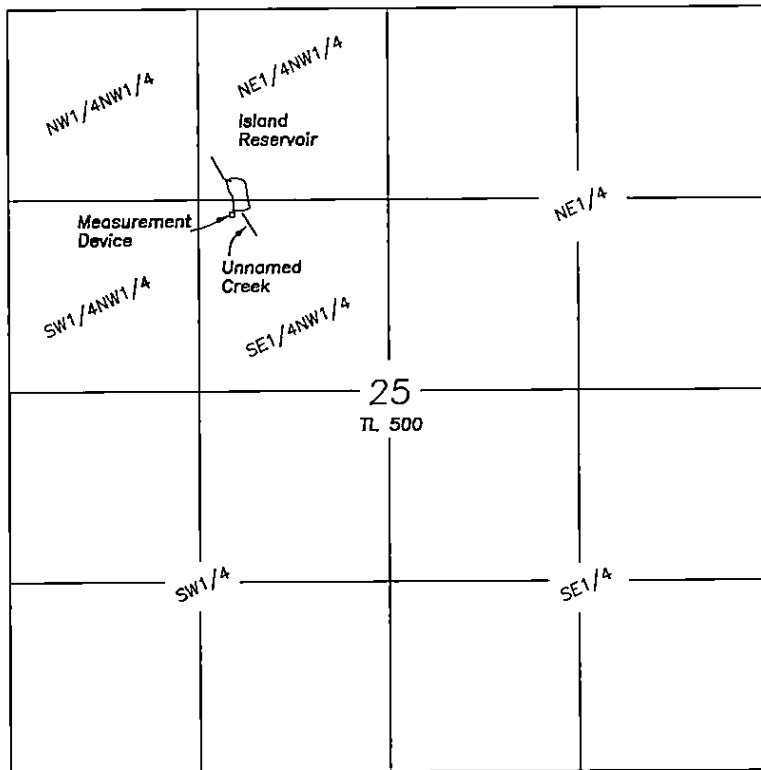

SCALE 1"=1320'

Outlet is located 1390' South & 1560' East of the NW corner of Section 25.

Measuring device is located 10' South of the outlet

FINAL PROOF SURVEY
CLAIM OF BENEFICIAL USE
ISLAND RESERVOIR

For

Bureau of Land Management

September 18, 2017

LEGEND

Application No. R-66176

Permit No. R-11129

Priority 1/16/1985

A portion of Tax Lot
24-36 TL 500

NOTE: Tax Lot 500 is owned by the BLM and is more that 17,000 acres. Therefore only a portion of the tax lot boundary can be shown.

NOTE: The preparation of this map was for the purpose of identifying the location of the proposed water right and has no intent to provide dimensions or location of property ownership lines.

Prepared by
Cornerstone Surveying, Inc

P.O. BOX 33
JOHN DAY, OR. 97845
(541)575-1813

cornerstonesurvey@centurytel.net

RECEIVED BY OWRD

NOV 03 2017

SALEM, OR

