

Claim of Beneficial Use Map A Water Right in the Name of City of Lincoln City Lincoln County

Permit R-13774, Application R-85474

Township 7 South, Range 11 West (W.M.)



Document Path: P:\Portland\893-Lincoln City\Project_GIS\Project_mxd\89313774_COBU.mxd


LEGEND

- Point of Diversion (POD)
- Outlet
- Place of Use (POU)
- Tax Lot
- Government Lot (GL)
- Watercourse
- Waterbody

POD LOCATION DESCRIPTION

Center of Dam
Located 532 feet South and 526 feet East from the S1/16 corner of Section 11, Township 7 South, Range 11 West (W.M.)

Certified Water Rights Examiner Stamp

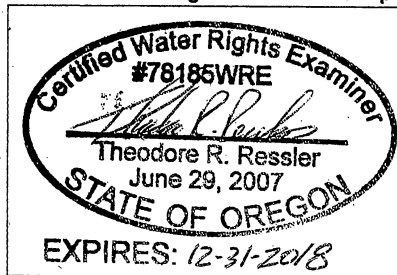

DISCLAIMER

This map was prepared for the purpose of identifying the location of a water right only and it is not intended to provide legal dimensions or location of property ownership lines.

MAP NOTES

Date: June 26, 2017
Data Sources: BLM, Lincoln Co., ESRI, USGS

