

CLAIM OF BENEFICIAL USE MAP

LOCATED IN GOVERNMENT LOT 2 OF SECTION 4,
TOWNSHIP 33 SOUTH, RANGE 15 WEST, W.M., COOS COUNTY, OREGON
APPLICATION R-80541, PERMIT R-12517



SCALE
1" = 200 FT.

SURVEY METHOD:

THE POINT OF DIVERSION WAS TIED BY TOTAL STATION TRAVERSE TO THE MONUMENTS SHOWN PER CURRY COUNTY SURVEY 33-308. THE POSITION OF THE SOUTH 1/4 CORNER OF SECTION 4 WAS CALCULATED BASED ON DIMENSIONS SHOWN PER CS33-308.

NOTE:

THE POINT OF DIVERSION IS LOCATED NORTH 660 FEET AND WEST 22 FEET FROM THE SOUTH 1/4 CORNER OF SECTION 4.

THE DAM OUTLET IS LOCATED NORTH 656 FEET AND WEST 9 FEET OF SAID SOUTH 1/4 CORNER.

LEGEND



POINT OF DIVERSION
PERMIT S-53453

1-1/4" POLY PIPE



FOUND MONUMENT AS NOTED



CALCULATED POSITION




HOSE BIB



IRRIGATED AREA = 0.30 ACRES



RECORD DIMENSION
PER CS33-308

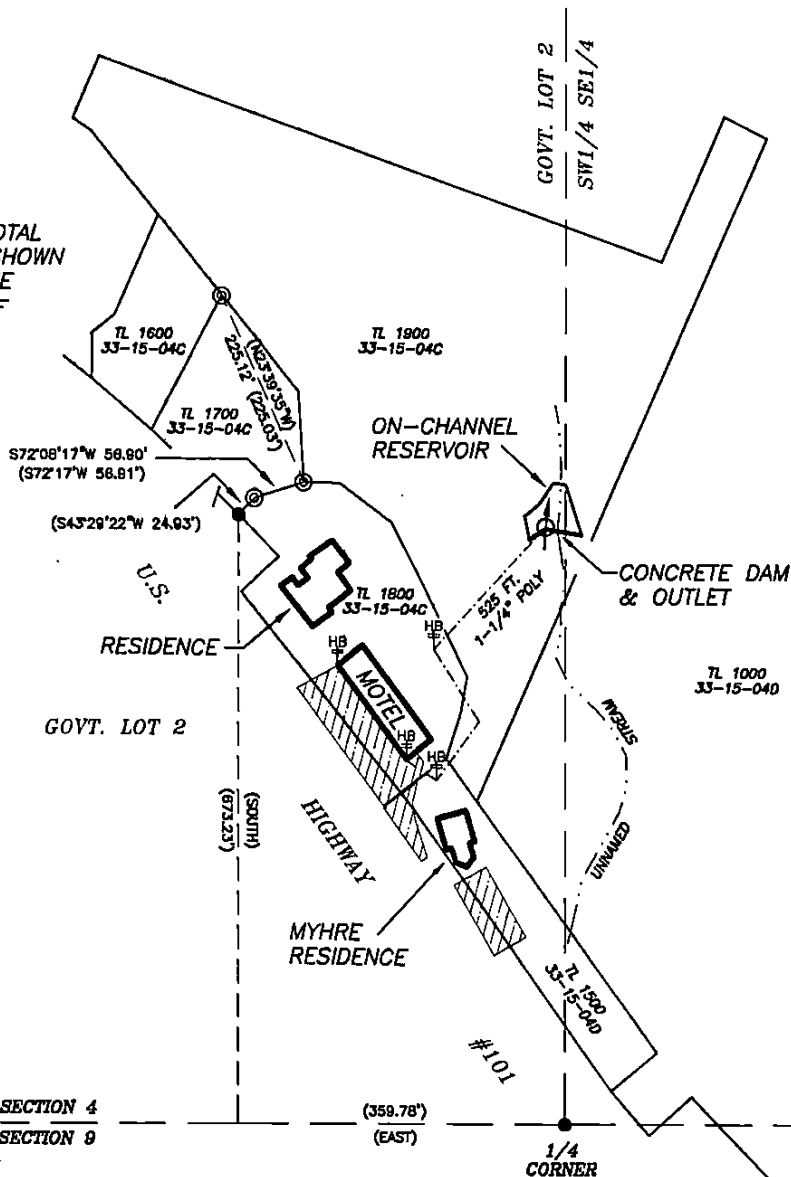

EXAMINER'S DISCLAIMER STATEMENT
THE PREPARATION OF THIS MAP WAS FOR THE PURPOSE
OF IDENTIFYING THE LOCATION OF THE WATER RIGHT ONLY
AND HAS NO INTENT TO PROVIDE DIMENSIONS OR
LOCATION OF PROPERTY OWNERSHIP LINES.

RECEIVED BY OWRD

MAY 29 2014

SALEM, OR



705 S. 4TH ST.
P.O. BOX 118
COOS BAY, OREGON 97420

PHONE: (541) 267-2872
FAX: (541) 267-0588
www.stuntzner.com

Engineering - Land Surveying - Forestry - Land Planning - Water Rights

JOB #: 114-054
DATE: May 2014
DRAWN BY: CMW
CHECKED BY: CMW

PREPARED
FOR:

Martin & Carol Myhre
Port Orford, Oregon

FILE NAME: 114-054 Myhre COBU.dwg

SHEET 1 OF 1