

CLAIM OF BENEFICIAL USE MAP

LOCATED IN GOVERNMENT LOT 2 OF SECTION 4,
TOWNSHIP 33 SOUTH, RANGE 15 WEST, W.M., COOS COUNTY, OREGON
APPLICATION S-80540, PERMIT S-53453



SCALE
1" = 200 FT.

SURVEY METHOD:


THE POINT OF DIVERSION WAS TIED BY TOTAL STATION TRAVERSE TO THE MONUMENTS SHOWN PER CURRY COUNTY SURVEY 33-308. THE POSITION OF THE SOUTH 1/4 CORNER OF SECTION 4 WAS CALCULATED BASED ON DIMENSIONS SHOWN PER CS33-308.

NOTE:

THE POINT OF DIVERSION IS LOCATED NORTH 660 FEET AND WEST 22 FEET FROM THE SOUTH 1/4 CORNER OF SECTION 4.
THE DAM OUTLET IS LOCATED NORTH 656 FEET AND WEST 9 FEET OF SAID SOUTH 1/4 CORNER.

LEGEND

- POINT OF DIVERSION PERMIT S-53453
- 1-1/4" POLY PIPE
- FOUND MONUMENT AS NOTED
- CALCULATED POSITION
- HOSE BIB
- IRRIGATED AREA = 0.30 ACRES
- RECORD DIMENSION PER CS33-308

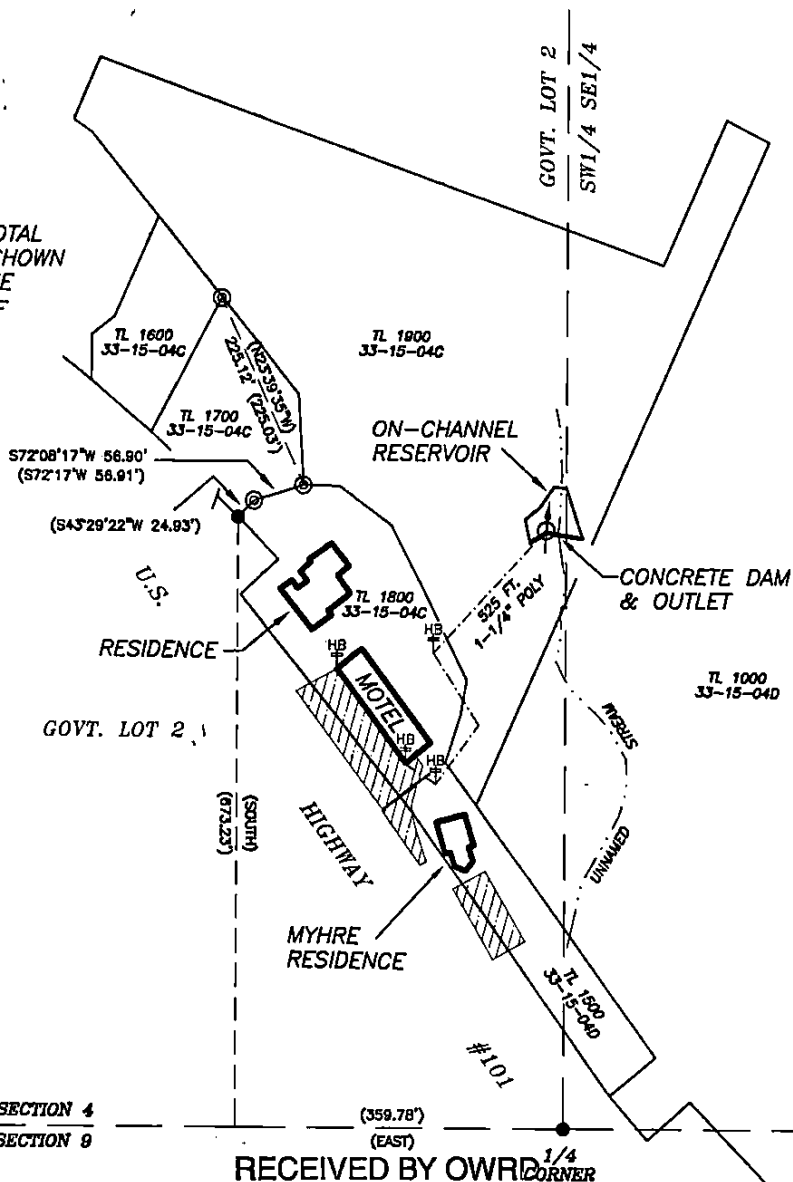

RECEIVED BY OWRD 1/4 CORNER

EXAMINER'S DISCLAIMER STATEMENT

THE PREPARATION OF THIS MAP WAS FOR THE PURPOSE OF IDENTIFYING THE LOCATION OF THE WATER RIGHT ONLY AND HAS NO INTENT TO PROVIDE DIMENSIONS OR LOCATION OF PROPERTY OWNERSHIP LINES.

MAY 29 2014

SALEM, OR



Stuntzner
Engineering & Forestry, LLC

705 S. 4TH ST.
P.O. BOX 118
COOS BAY, OREGON 97420

PHONE: (541) 267-2872
FAX: (541) 267-0588
www.stuntzner.com

Engineering - Land Surveying - Forestry - Land Planning - Water Rights

JOB #: 114-054

DATE: May 2014

DRAWN BY: CMW

CHECKED BY: CMW

PREPARED FOR:

FOR:

Martin & Carol Myhre
Port Orford, Oregon

FILE NAME: 114-054 Myhre COBU.dwg

SHEET 1 OF 1