
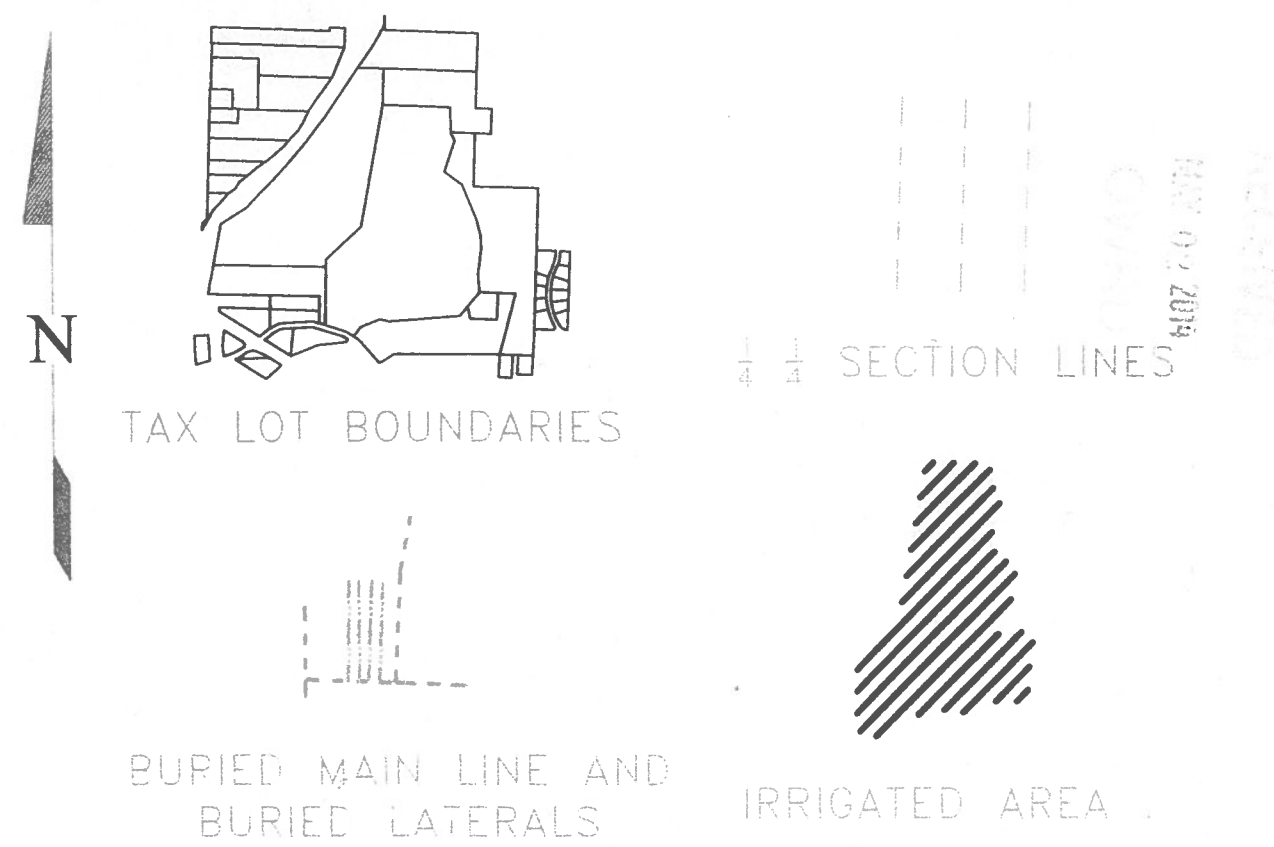


This map is not intended to provide legal dimensions or locations of property ownership lines

Township 18 S Range 2 West Sections 20 and 29

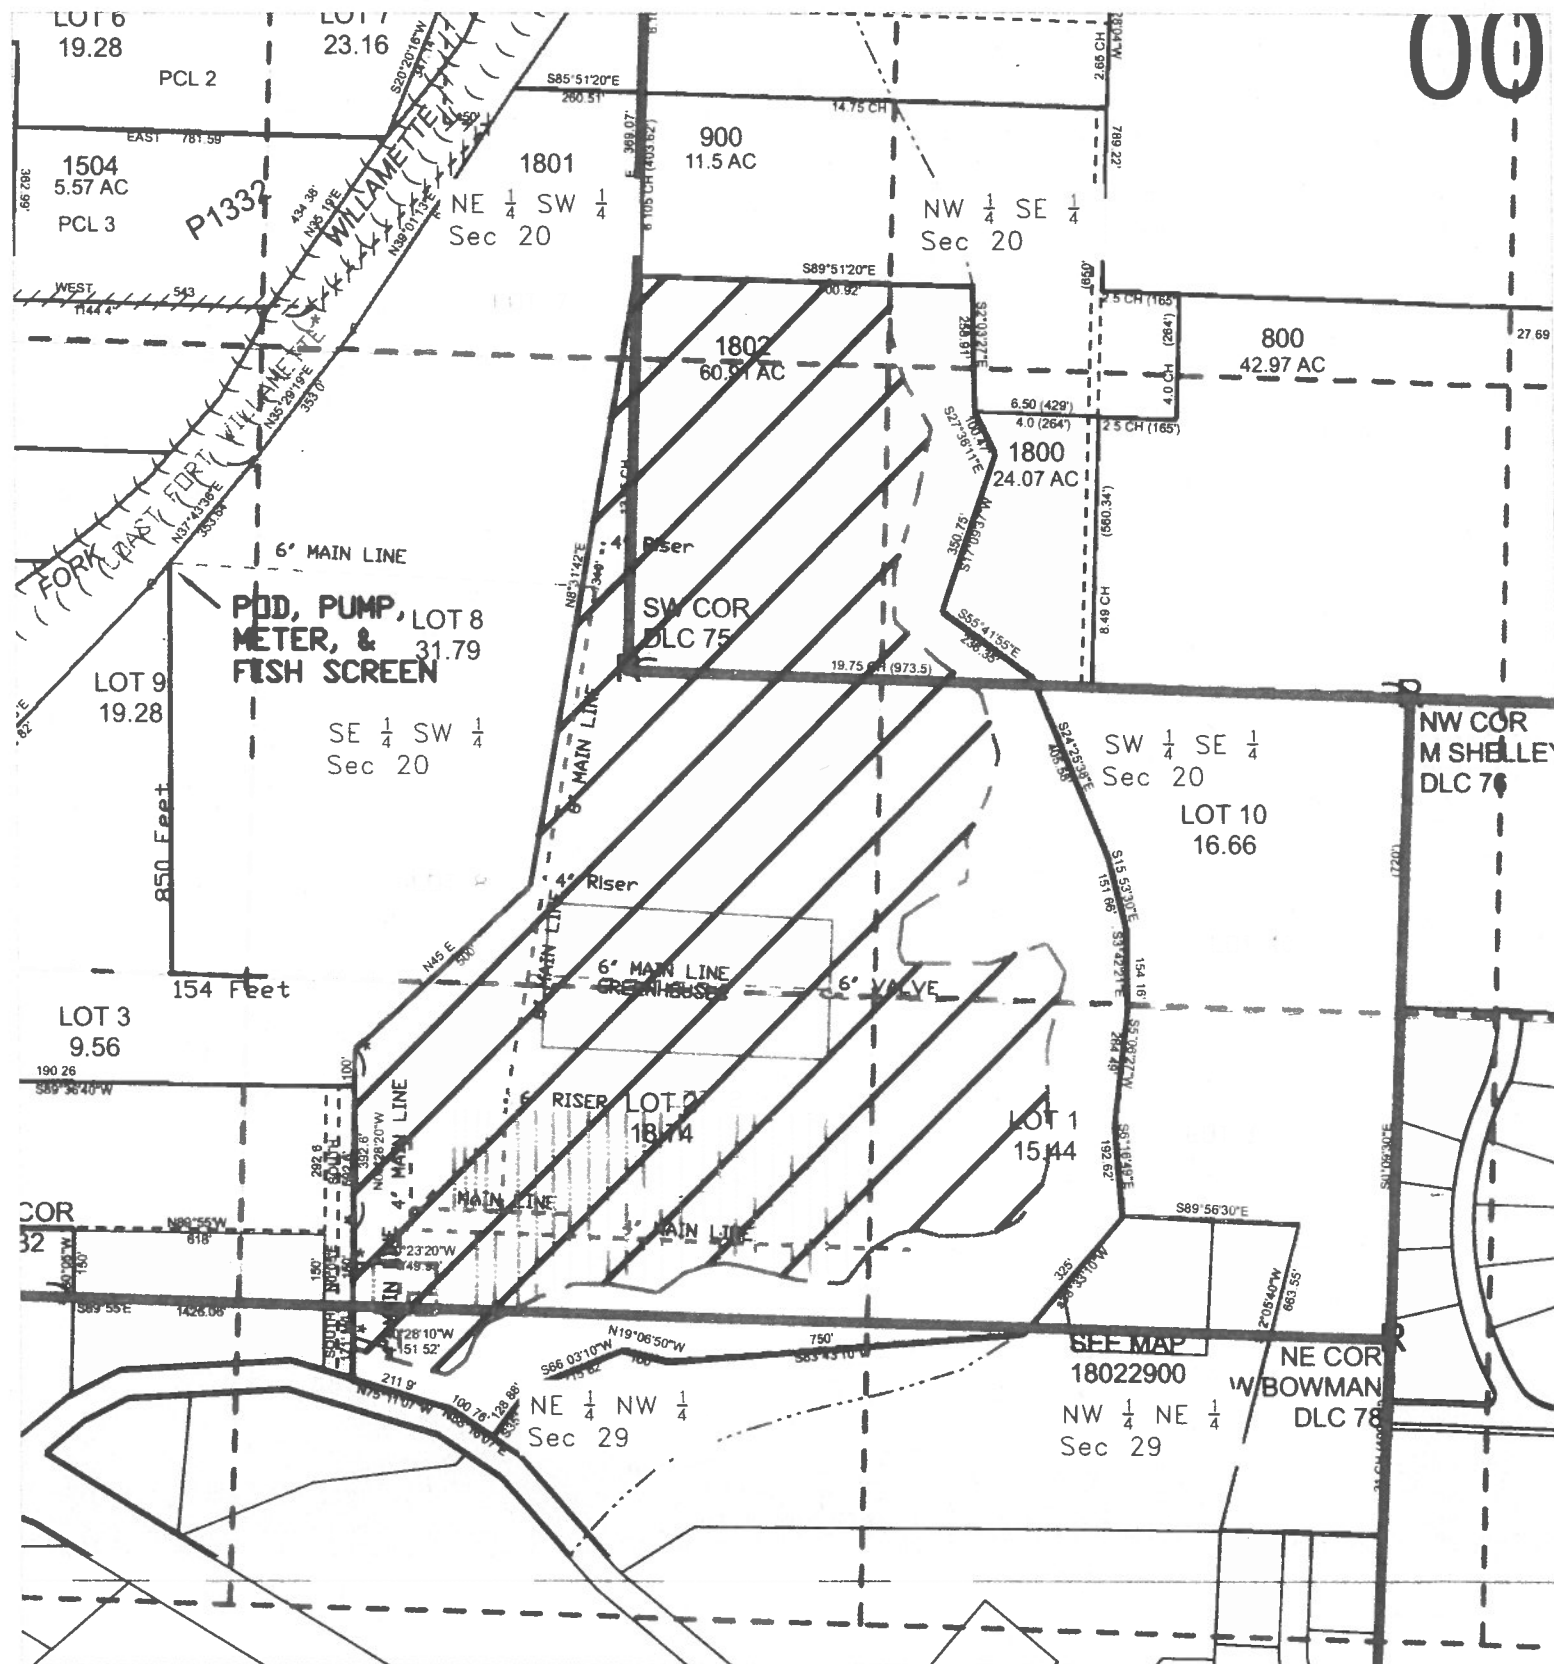

Township 18 South Range 2 West Lane County
Tax Lot 18-02-20-00-01802

Section	1/4 1/4	Government Lot	DLC	Acreage
29	NE NW		78	0.678
29	NE NW	2		14.971
29	NW NE	1		3.954
20	SW SE	10		3.266
20	SE SW	8		12.328
20	NE SW	7		0.059
20	NE SW		75	2.074
20	NW SE		75	0.034
20	SW SE		75	0.874
20	SE SW		75	7.861
Total Acreage				46.100

D.I.C. BOUNDARY

Certified Water Right Examiner
76773WRE
Steven I. Recca
Steven I Recca
June 29, 2007
STATE OF OREGON

EXPIRATION DATE: 12/31/14

COBU MAP #824 1" CH = 400 FEET

FINAL PROOF SURVEY
PERMIT S-53669, APPLICATION S-84064
Coast Fork LLC
LOWELL, OREGON

EGR & Associates, Inc.
Engineers, Geologists and Surveyors
25355 Prairie Road
Eugene, Oregon 97402
541-688-8322
541-683-3067

824