

CLAIM OF BENEFICIAL USE MAP


DOMENICO GIANCOLA

TAX LOT 2101


LOCATED IN THE SE 1/4 OF SECTION 27, T.1S., R.3E., W.M.
CLACKAMAS COUNTY, OREGON

AN UNNAMED RESERVOIR

APPLICATION NO. 73860, PERMIT NO. R12748

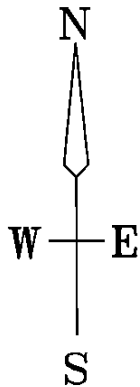

SCALE
1"=200'

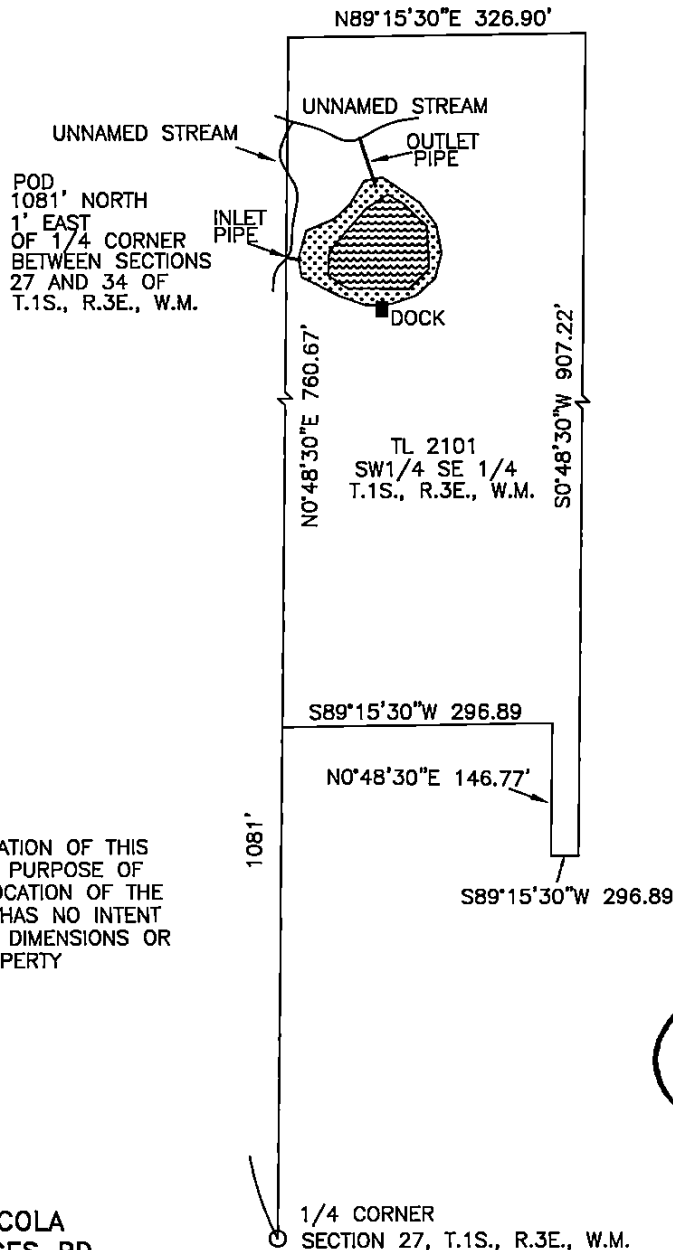

STORAGE CAPACITY
1.38 AF

WATER LEVEL AS OF
OCTOBER 10, 2014
0.76 AF


NOTE: THE PREPARATION OF THIS
MAP WAS FOR THE PURPOSE OF
IDENTIFYING THE LOCATION OF THE
WATER RIGHT AND HAS NO INTENT
TO PROVIDE LEGAL DIMENSIONS OR
LOCATIONS OF PROPERTY
OWNERSHIP LINES.

CLIENT:
DOMENICO GIANCOLA
23401 SE BORGES RD
DAMASCUS, OREGON

RECEIVED BY OWRD

OCT 27 2014

SALEM, OR

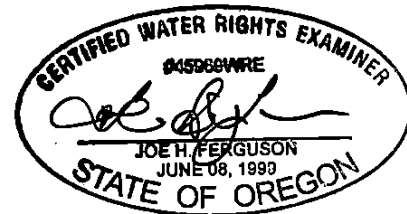

Ferguson Land Surveying, Inc.

646 SE 106TH AVE. PORTLAND, OR 97216
Phone (503) 408-0601 Fax (503) 408-0602

SHEET NO. 1 OF 1

JOB NO. 14-132 CBU

DRAFTED 10/21/2014