


T. 26 S., R. 31 E., W.M.

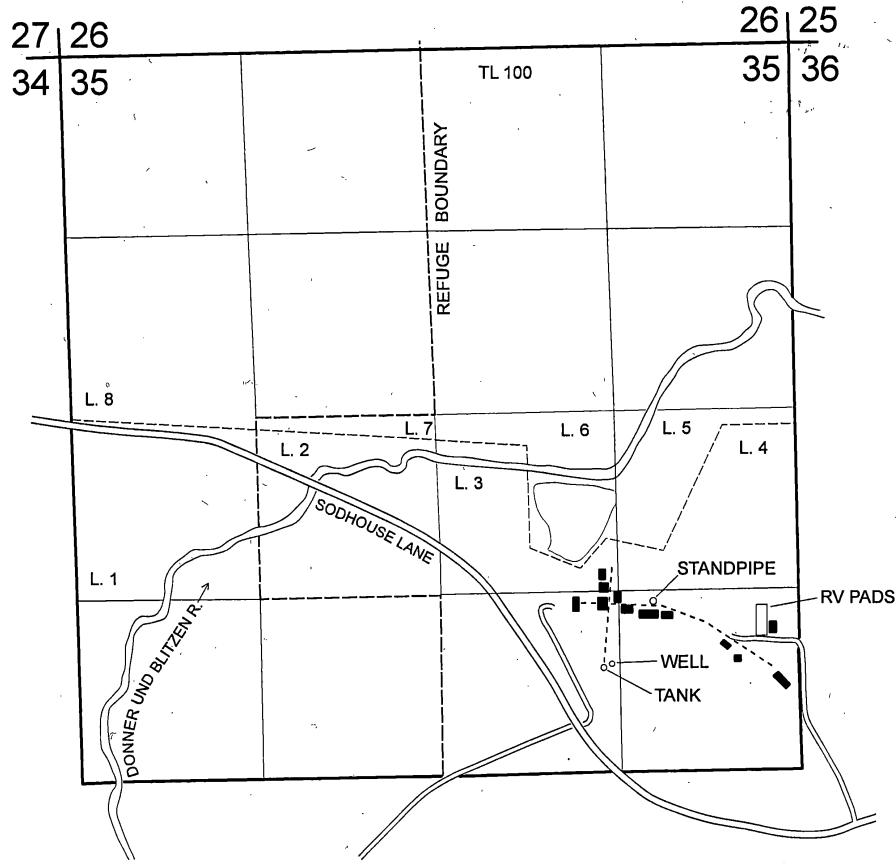

1 INCH = 1320 FEET

WELL IS LOCATED 620 FT NORTH AND
1385 FT WEST FROM THE SE CORNER
OF SECTION 35, BEING WITHIN THE
SW¼ SE¼ OF SECTION 35.

RECEIVED

OCT 22 2008

WATER RESOURCES DEPT
SALEM, OREGON

FINAL PROOF SURVEY

UNDER

Application No. G-15768 Permit No. G-15410

IN THE NAME OF

U.S. FISH & WILDLIFE SERVICE
(MALHEUR NWR HEADQUARTERS)



RENEWS: 12/31/2009

This map is not intended to provide
legal dimensions or locations of
property ownership lines.