
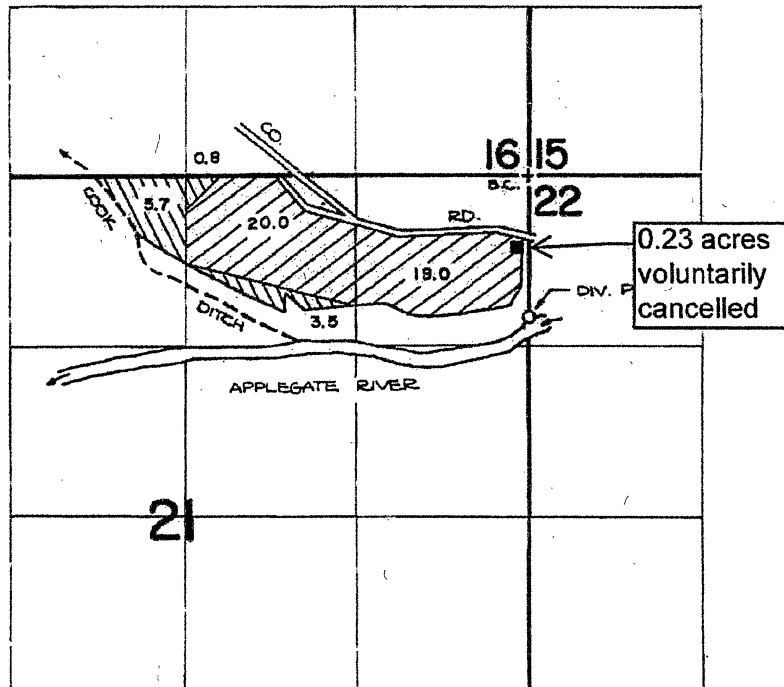


T.38S. R.4W. W.M.

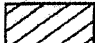

DIVERSION POINT IS LOCATED 1130'S. AND 10' W. FROM THE N.E. CORNER OF SECTION 21.

 CHANGE IN P.O.D. AND P.O.U.

 CHANGE IN P.O.D. ONLY

FINAL PROOF SURVEY UNDER

TRANSFER NO. 3430

Application No. Permit No.
IN NAME OF

BENJAMIN F. & LAURA S. ELLIS

Surveyed **JULY 22 1983**, by **B. JAMES**....

RECEIVED

MAR 19 2018

OWRD