



Cent 14525
Common Channel POD

SEP 05 2017
RECEIVED BY OWRD
SALEM, OR
SEP 05 2017
SALEM, OR

**Claim of Beneficial Use
Transfer T-11481 (Permit S-14906)**
Water Right in the Name of Port of Portland
Multnomah County
Township 1 North, Range 3 East (W.M.)

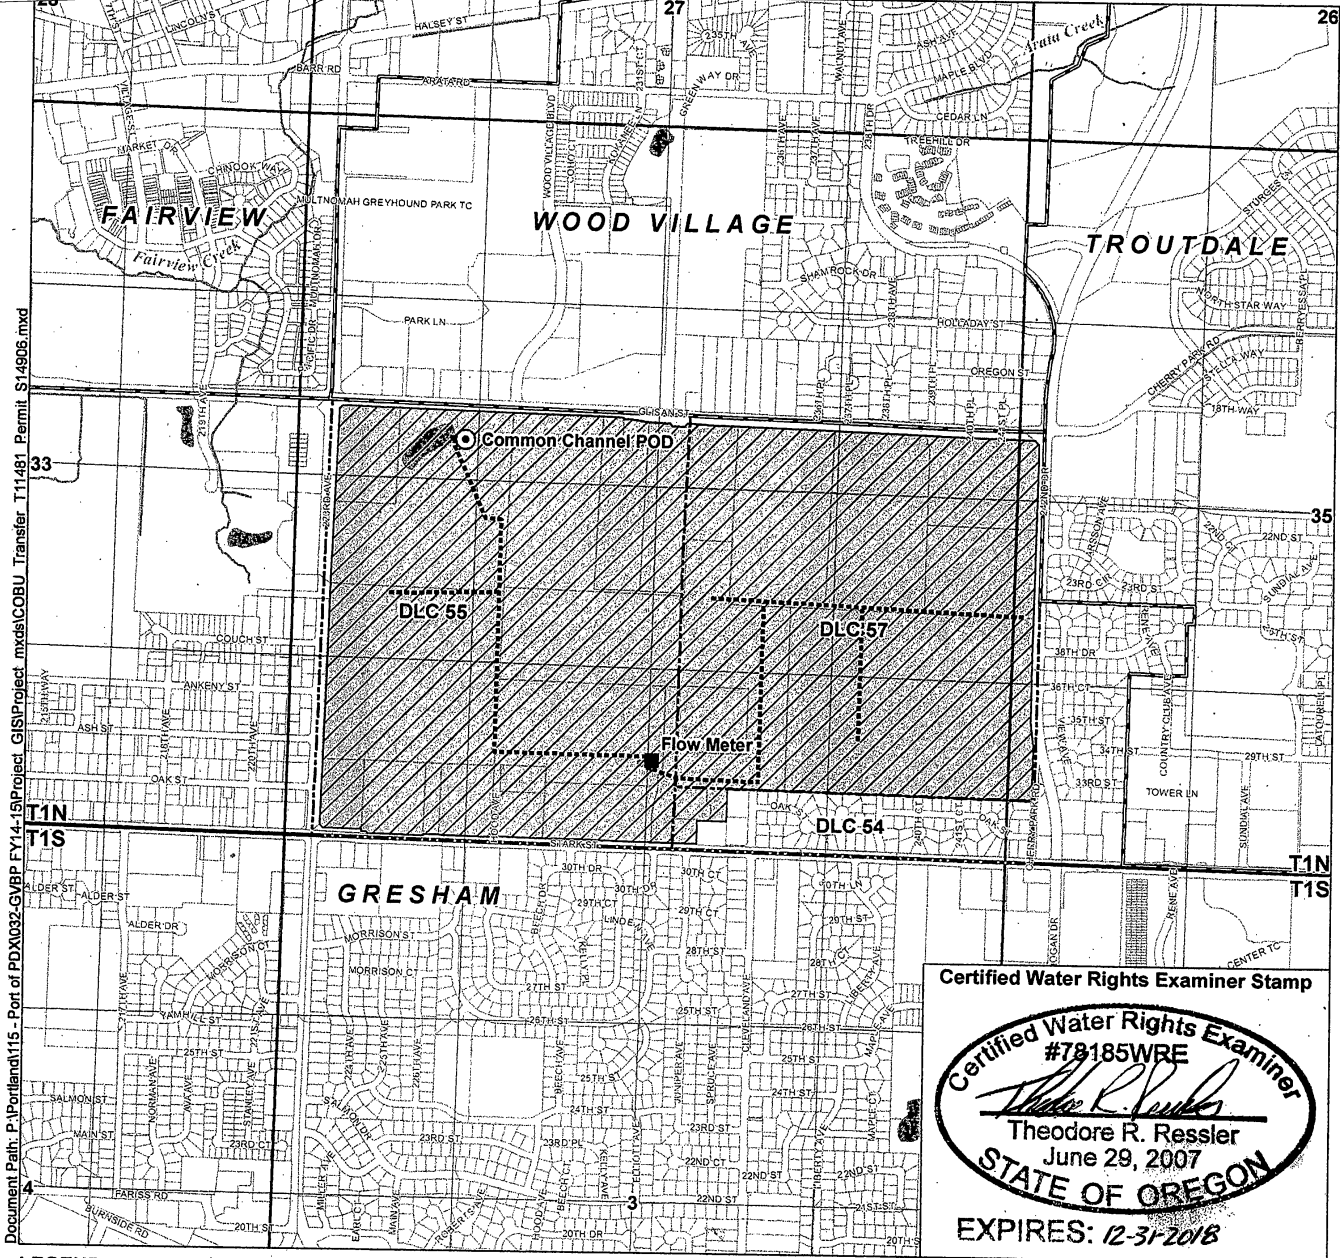

Document Path: P:\Portland\115 - Port of PD\032-GVBP FY14-15\Project_GIS\Project_mxd\GIS\COBU_Transfer_T11481_Permit_S14906.mxd

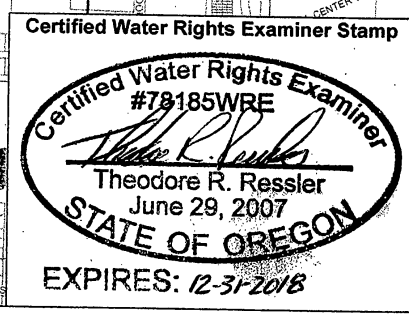

- LEGEND**
- Point of Diversion (POD)
 - ▨ Place of Use (POU)
- Gresham Vista Business Park
 - System Mainline
 - City Limit
 - Tax Lot
 - Donation Land Claim (DLC)
 - ~ Watercourse
 - Waterbody

POD Location Description
Common Channel POD
240 feet South and 1,000 feet East from the NW corner of Molloy
DLC 55, Section 34, Township 1 North, Range 3
East (W.M.).

Disclaimer
This map was prepared for the purpose of identifying the location of a water right only and it is not intended to provide legal dimensions or location of property ownership lines.

Map Notes
Date: June 23, 2015
Data Sources: OWRD, METRO RLIS, OGIC
Prepared By: GSI Water Solutions, Inc.

