


# Claim of Beneficial Use Permit S-53948 (Application S-71803)

Water Right in the Name of Sester Farms, Inc.  
County of Multnomah

Township 1 South, Range 4 East, Section 16 (W.M.)

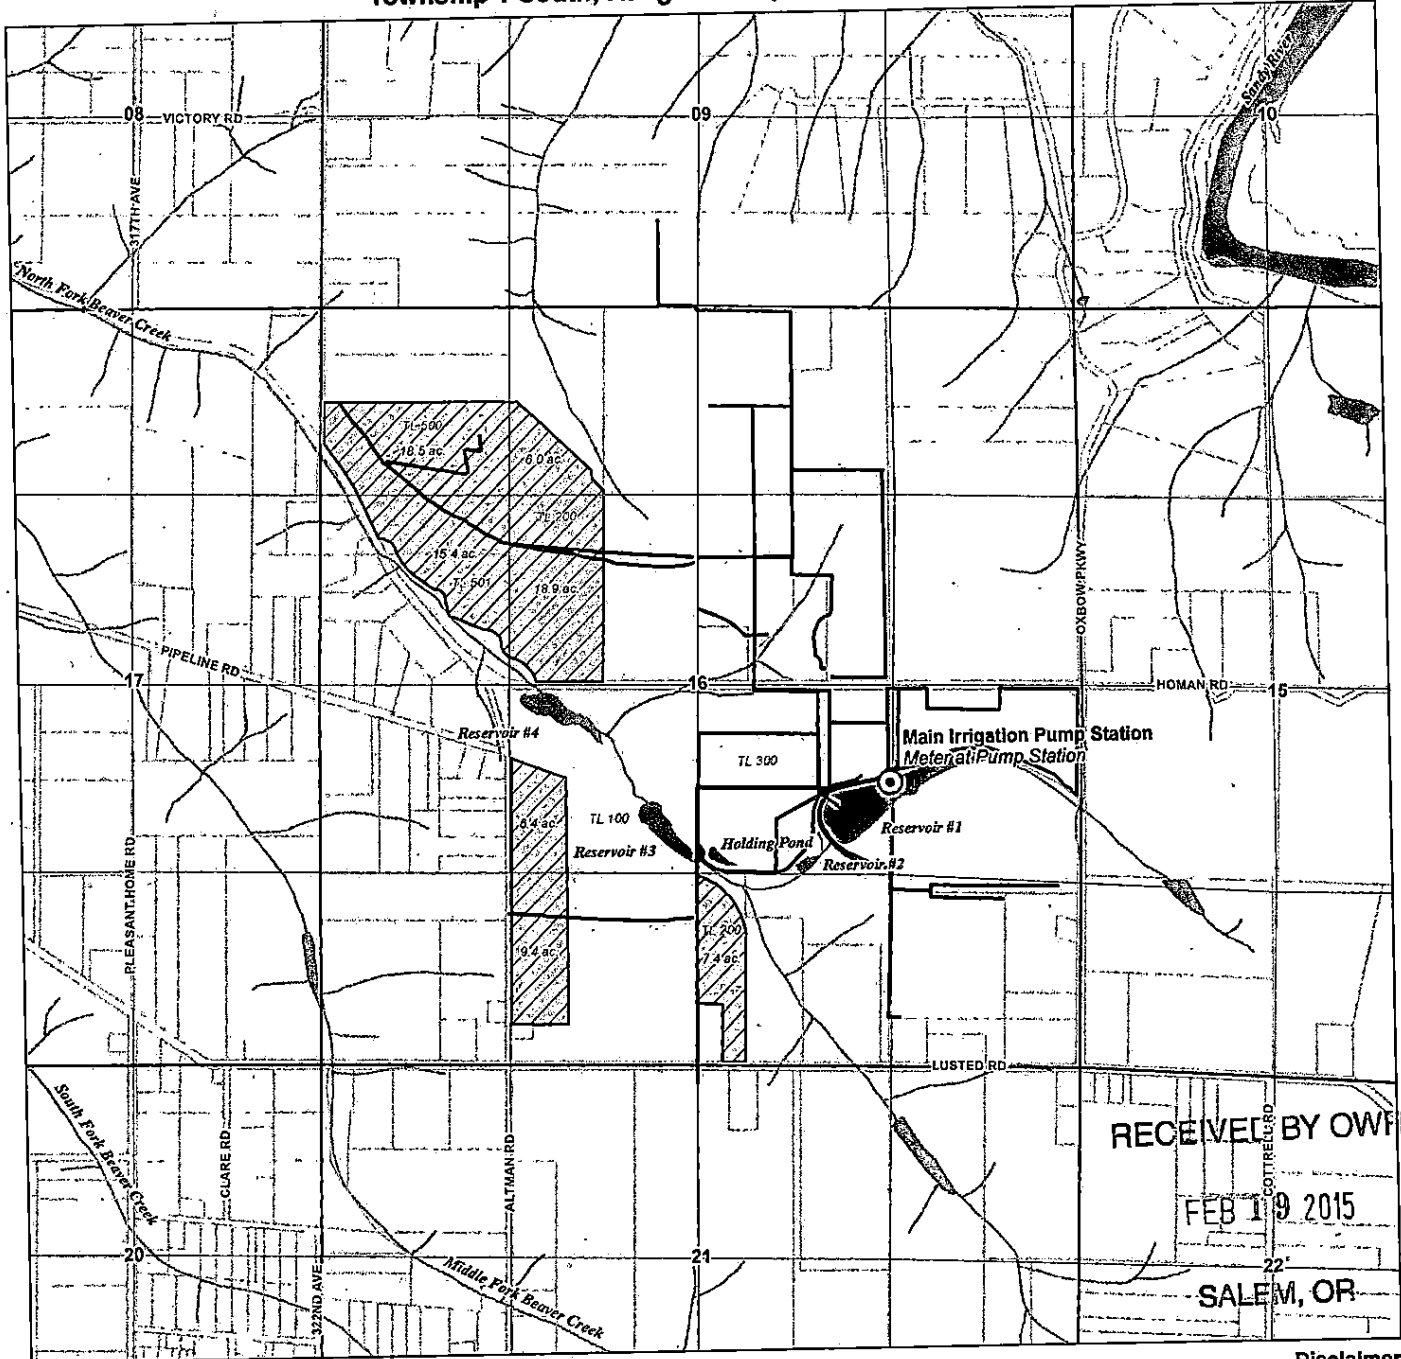


**LEGEND**

- Point of Diversion (POD)
- Place of Use (POU)
- Irrigation Mainline
- Tax Lot
- Watercourse
- Waterbody

**POD Location Description**

Main Irrigation Pump Station  
Located 650 feet South and 1,450 feet East from the center quarter corner of Section 16, Township 1 South, Range 4 East (W.M.)

**Certified Water Rights Examiner Stamp**

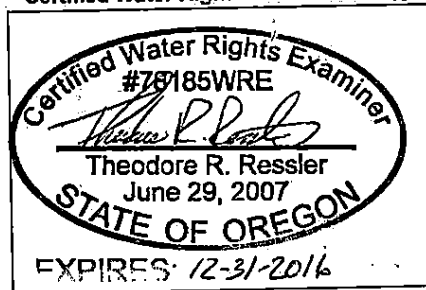

**Disclaimer:**  
This map was prepared for the purpose of identifying the location of a water right only and it is not intended to provide legal dimensions or location of property ownership lines.

**Map Notes**

Date: February 2, 2015  
Data Sources: METRO, BLM, USGS  
Prepared By: GSI Water Solutions, Inc.

