
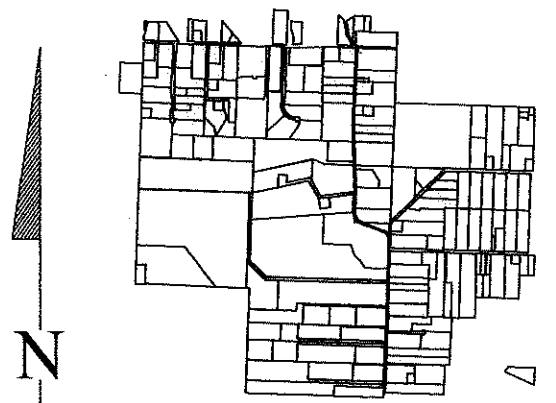



195

This map is not intended to provide legal dimensions or locations of property ownership lines


Township 17 S Range 6 West Sections 12 and 13

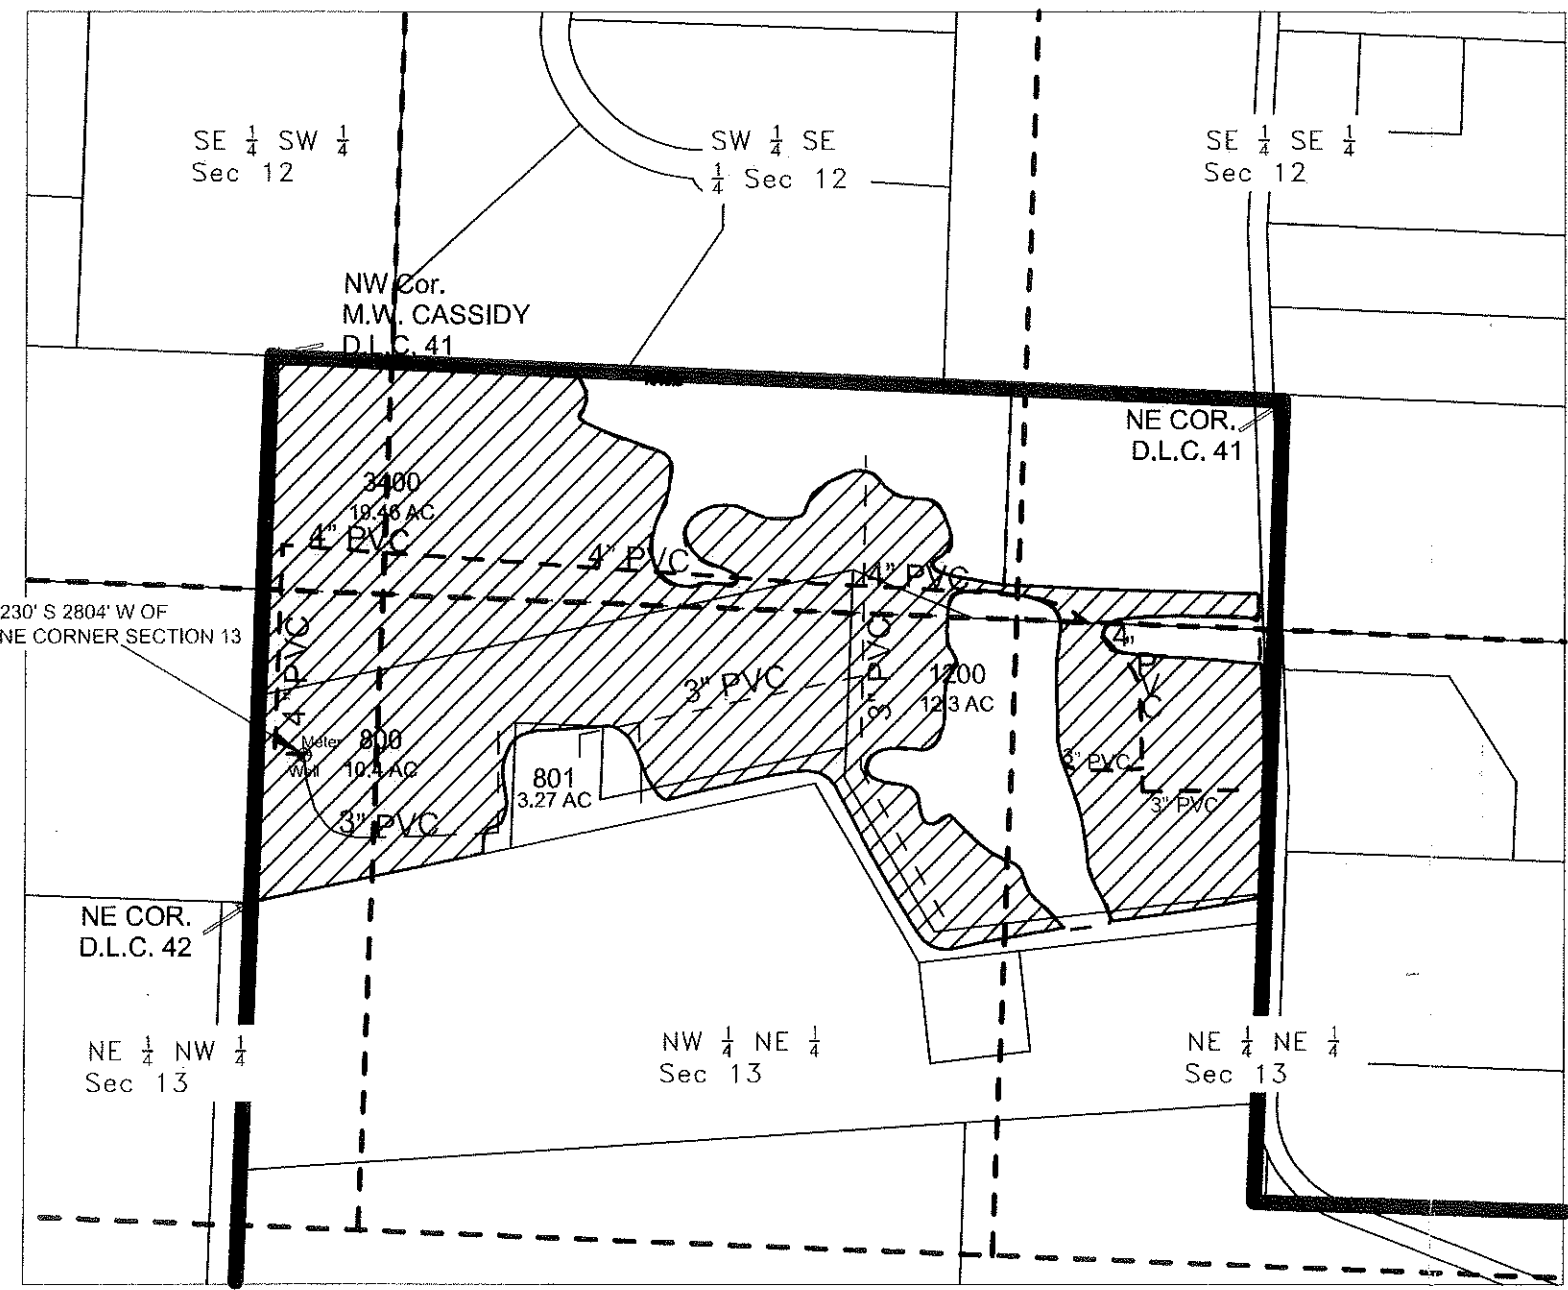

TAX LOT BOUNDARIES

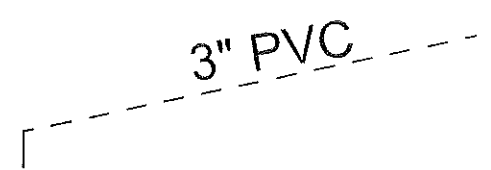

BURIED MAIN LINE

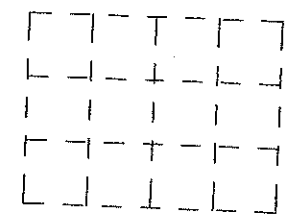

1/4 SECTION LINES




IRRIGATED AREA

Area of Use
All Within M.W. Casidy D.L.C 41

T 17 S R 6 W Sec 12	Tax Lot	Acres in Tax Lot
SE SE	170612-3400	0.623
SE SW	170612-3400	2.809
SW SE	170612-3400	8.123
SW SE	170613-800	0.360
SW SE	170613-1200	0.247

T 17 S R 6 W Sec 13		
NE NE	170613-1200	4.97
NE NW	170612-3400	1.079
NE NW	170613-800	2.492
NW NE	170613-800	7.164
NW NE	170613-801	0.916
NW NE	170613-1200	2.612
NW NE	170612-3400	1.111

Total 32.506

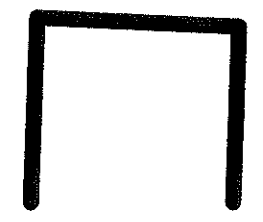

RECEIVED BY DWRD

OCT 28 2013


SALEM, OR

D.L.C. BOUNDARY



EXPIRATION DATE: 12/31/14

COBU MAP # 795

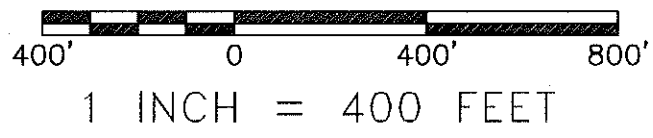

FINAL PROOF SURVEY
PERMIT G-15152, APPLICATION G-15316
ALVIN WILSON
ELMIRA, OREGON



EGR & Associates, Inc.
Engineers, Geologists, and Surveyors
2535B Prairie Road
Eugene, Oregon 97402
(541) 688-8322
Fax (541) 688-8087