

MAP TO ACCOMPANY CLAIM OF BENEFICIAL USE FOR
FOR CHANGE IN POINT OF DIVERSION AND PLACE OF USE


Alfred and Ginger Zuppan

RECEIVED

DEC 07 2001

WATER RESOURCES DEPT.
SALEM, OREGON

Dean

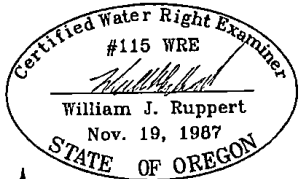


TRANSFER T-8493

MAP PREPARED BY:
WILLIAM J. RUPPERT
P.O. BOX 1564
MYRTLE CREEK, OR 97457
AUGUST, 2001

SCALE 1"=1320'

T29S R3W WM

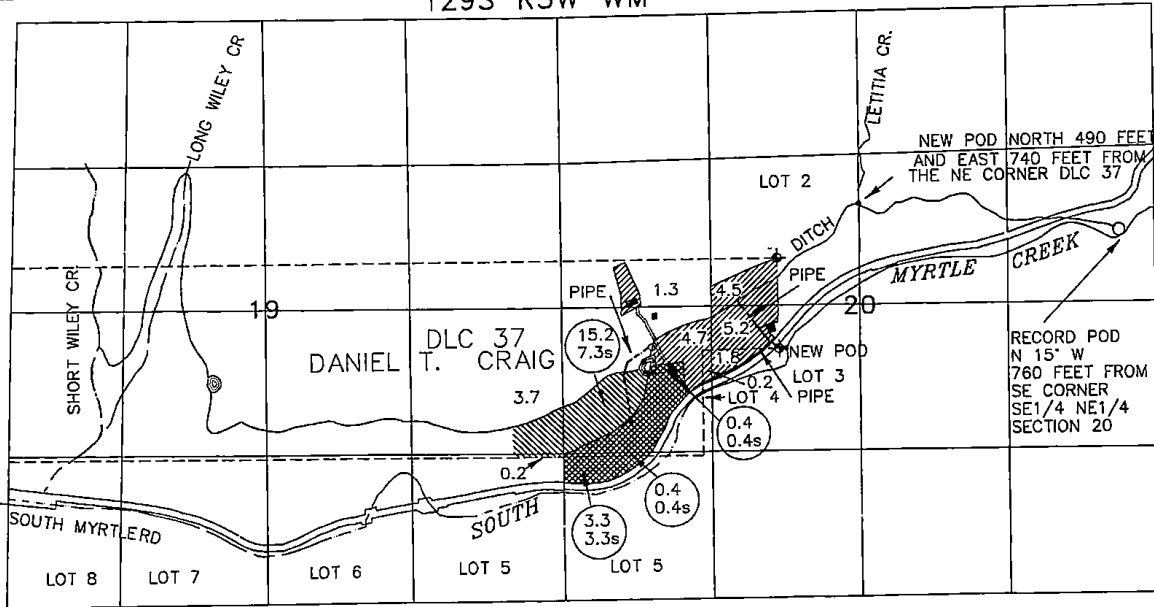


THIS MAP TO BE USED FOR WATER RIGHT PURPOSES ONLY