

DESCHUTES COUNTY, OREGON


1" = 400'

T 20 S, R 10 E, WM


SECTION 23 NESE
SWSE
SESE

SECTION 24 NWSW
SWSW

APP G-12311 PERMIT G-11265 T-10182

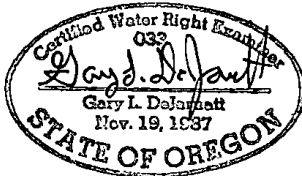

RENEWAL DATE: 12-31-2013

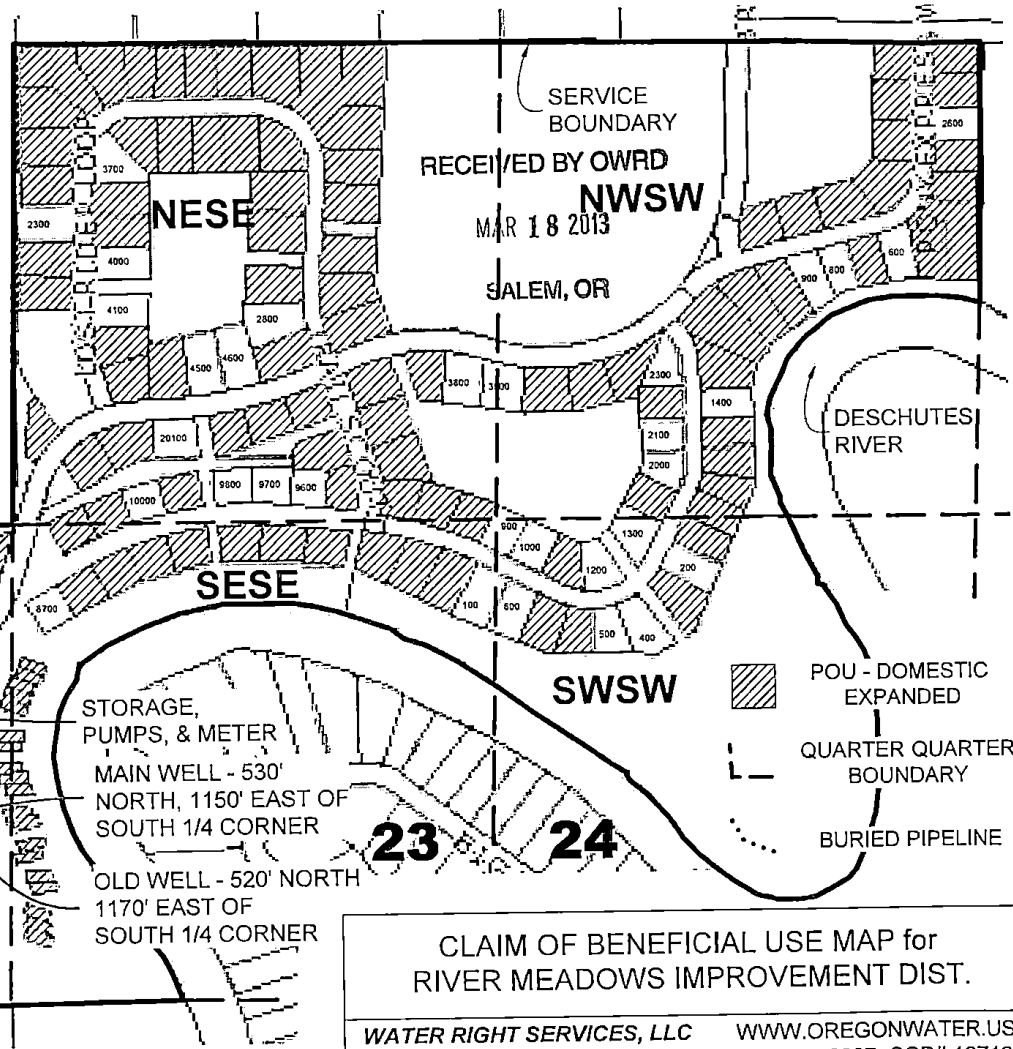

STORAGE,
PUMPS, & METER
MAIN WELL - 530'
NORTH, 1150' EAST OF
SOUTH 1/4 CORNER
OLD WELL - 520' NORTH
1170' EAST OF
SOUTH 1/4 CORNER

23 24

CLAIM OF BENEFICIAL USE MAP for
RIVER MEADOWS IMPROVEMENT DIST.

WATER RIGHT SERVICES, LLC WWW.OREGONWATER.US
P.O. BOX 1830, BEND OR 97709 (541) 389-2837 CCB# 197121

DATE FEB 26, 2013 JOHNSHORT@USA.COM JOB# 13007

NOTE: THIS MAP IS NOT INTENDED TO PROVIDE LEGAL DIMENSIONS OR LOCATIONS OF PROPERTY OWNERSHIP LINES.

S 1/4 CORNER