


ACMPC OREGON I, LLC
T8S R4W, W.M.



scale 4" = 1 mile

DLC Line	— — — —		Cert. 81572 RR
Section Line	— — — —		Cert. 39081
1/4 1/4 Line	— — — —		Cert. 39081
Property Line Adjustment	- - - - -		Cert. 39081
Buried PVC mainline	- - - - -		On Setniker Land


CERTIFIED WATER RIGHT EXAMINER
30680
William E. McGill
WILLIAM E. MCGILL
MAY 3, 2011
STATE OF OREGON
EXPIRES: 12/31/2018

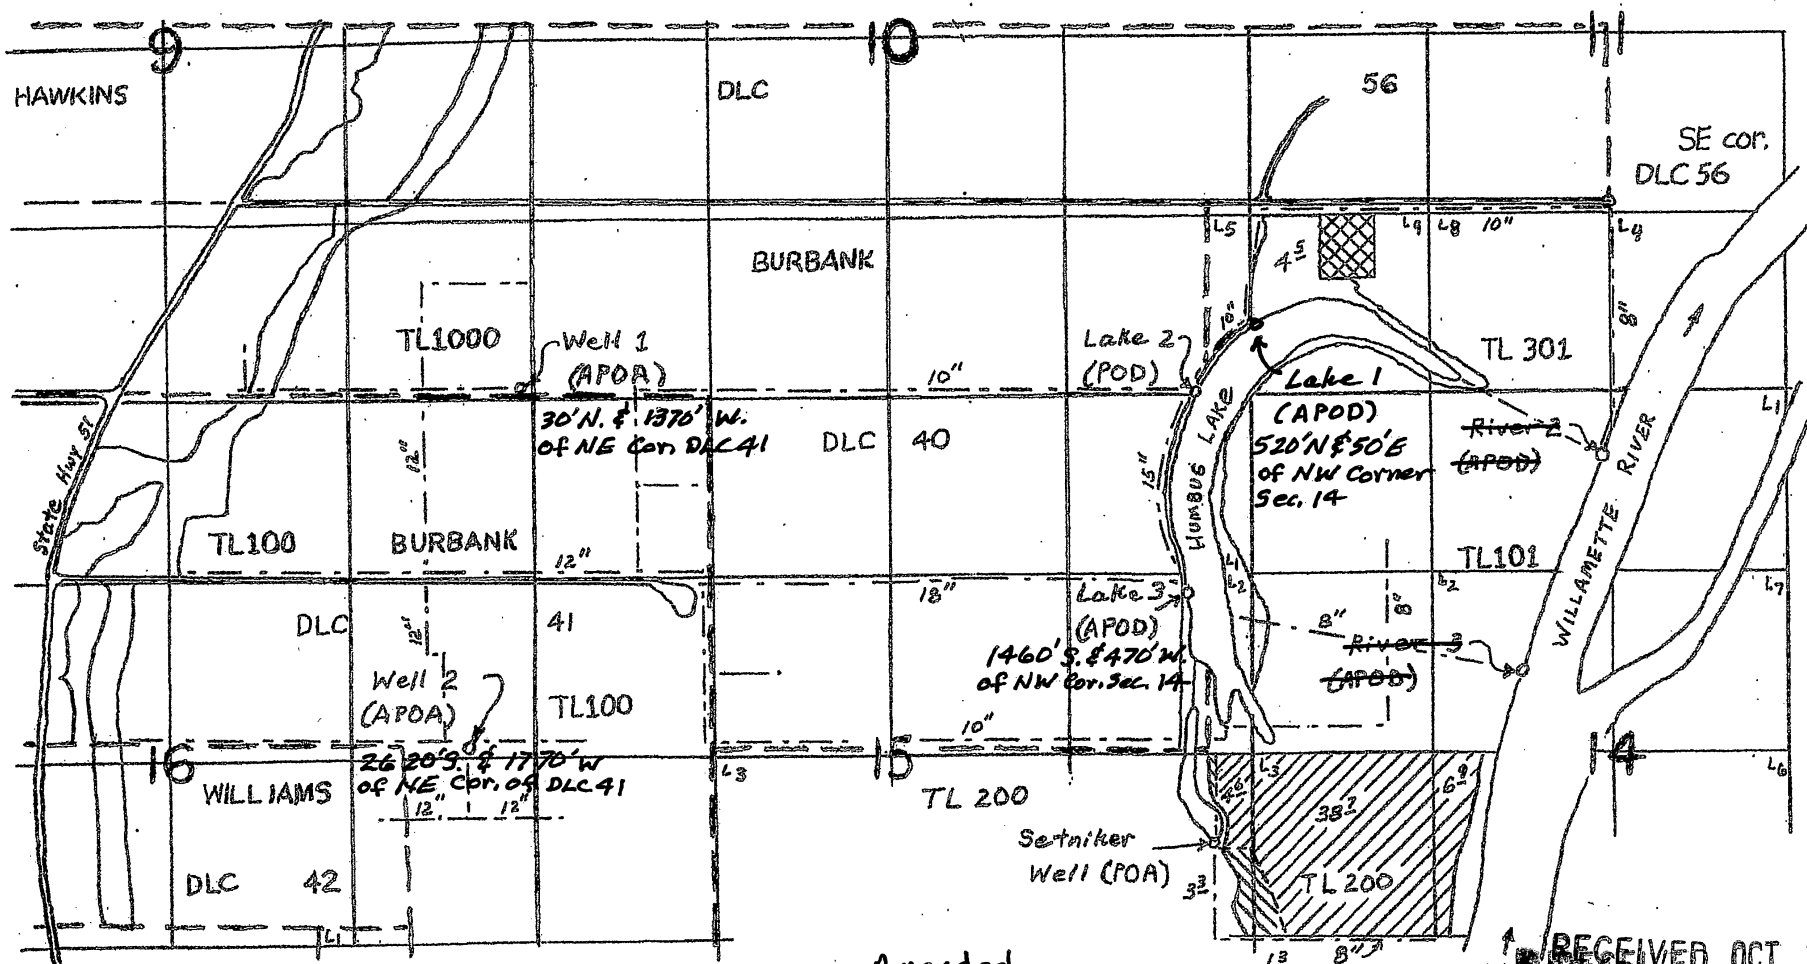

Amended
10-25-17 WEM

RECEIVED OCT 30 2017

T.8S.R.4W.W.M.

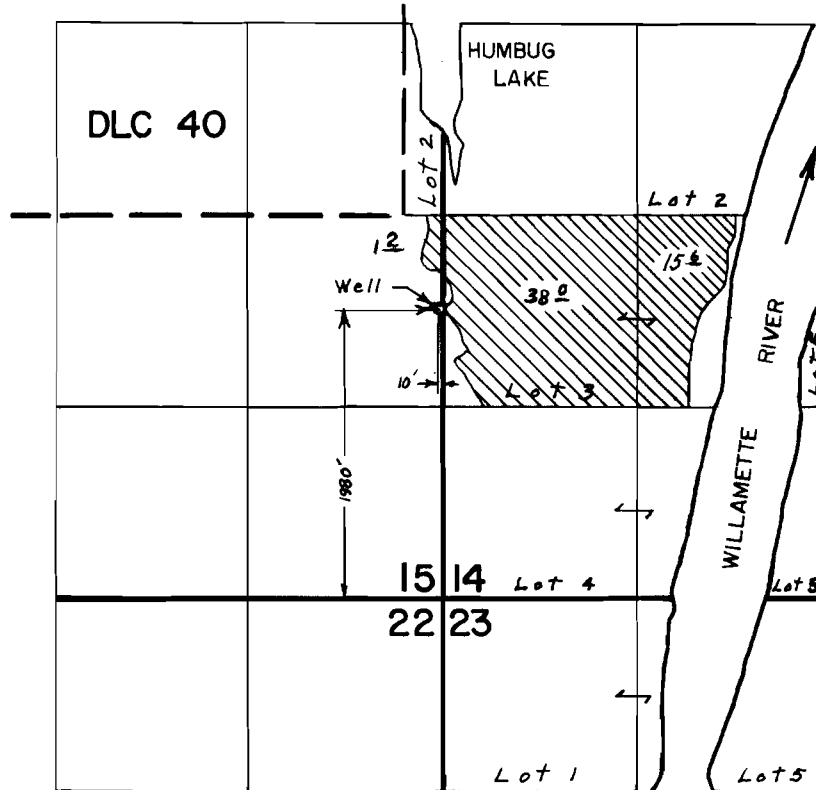

FINAL PROOF SURVEY UNDER

Application No. G-5059 Permit No. G-4769
IN NAME OF

JOHN N. HOOPER

Surveyed NOV 10 1972, by L. GOULD.