


RECEIVED
MAY 19 1980
WATER RESOURCES DEPT
SALEM, OREGON

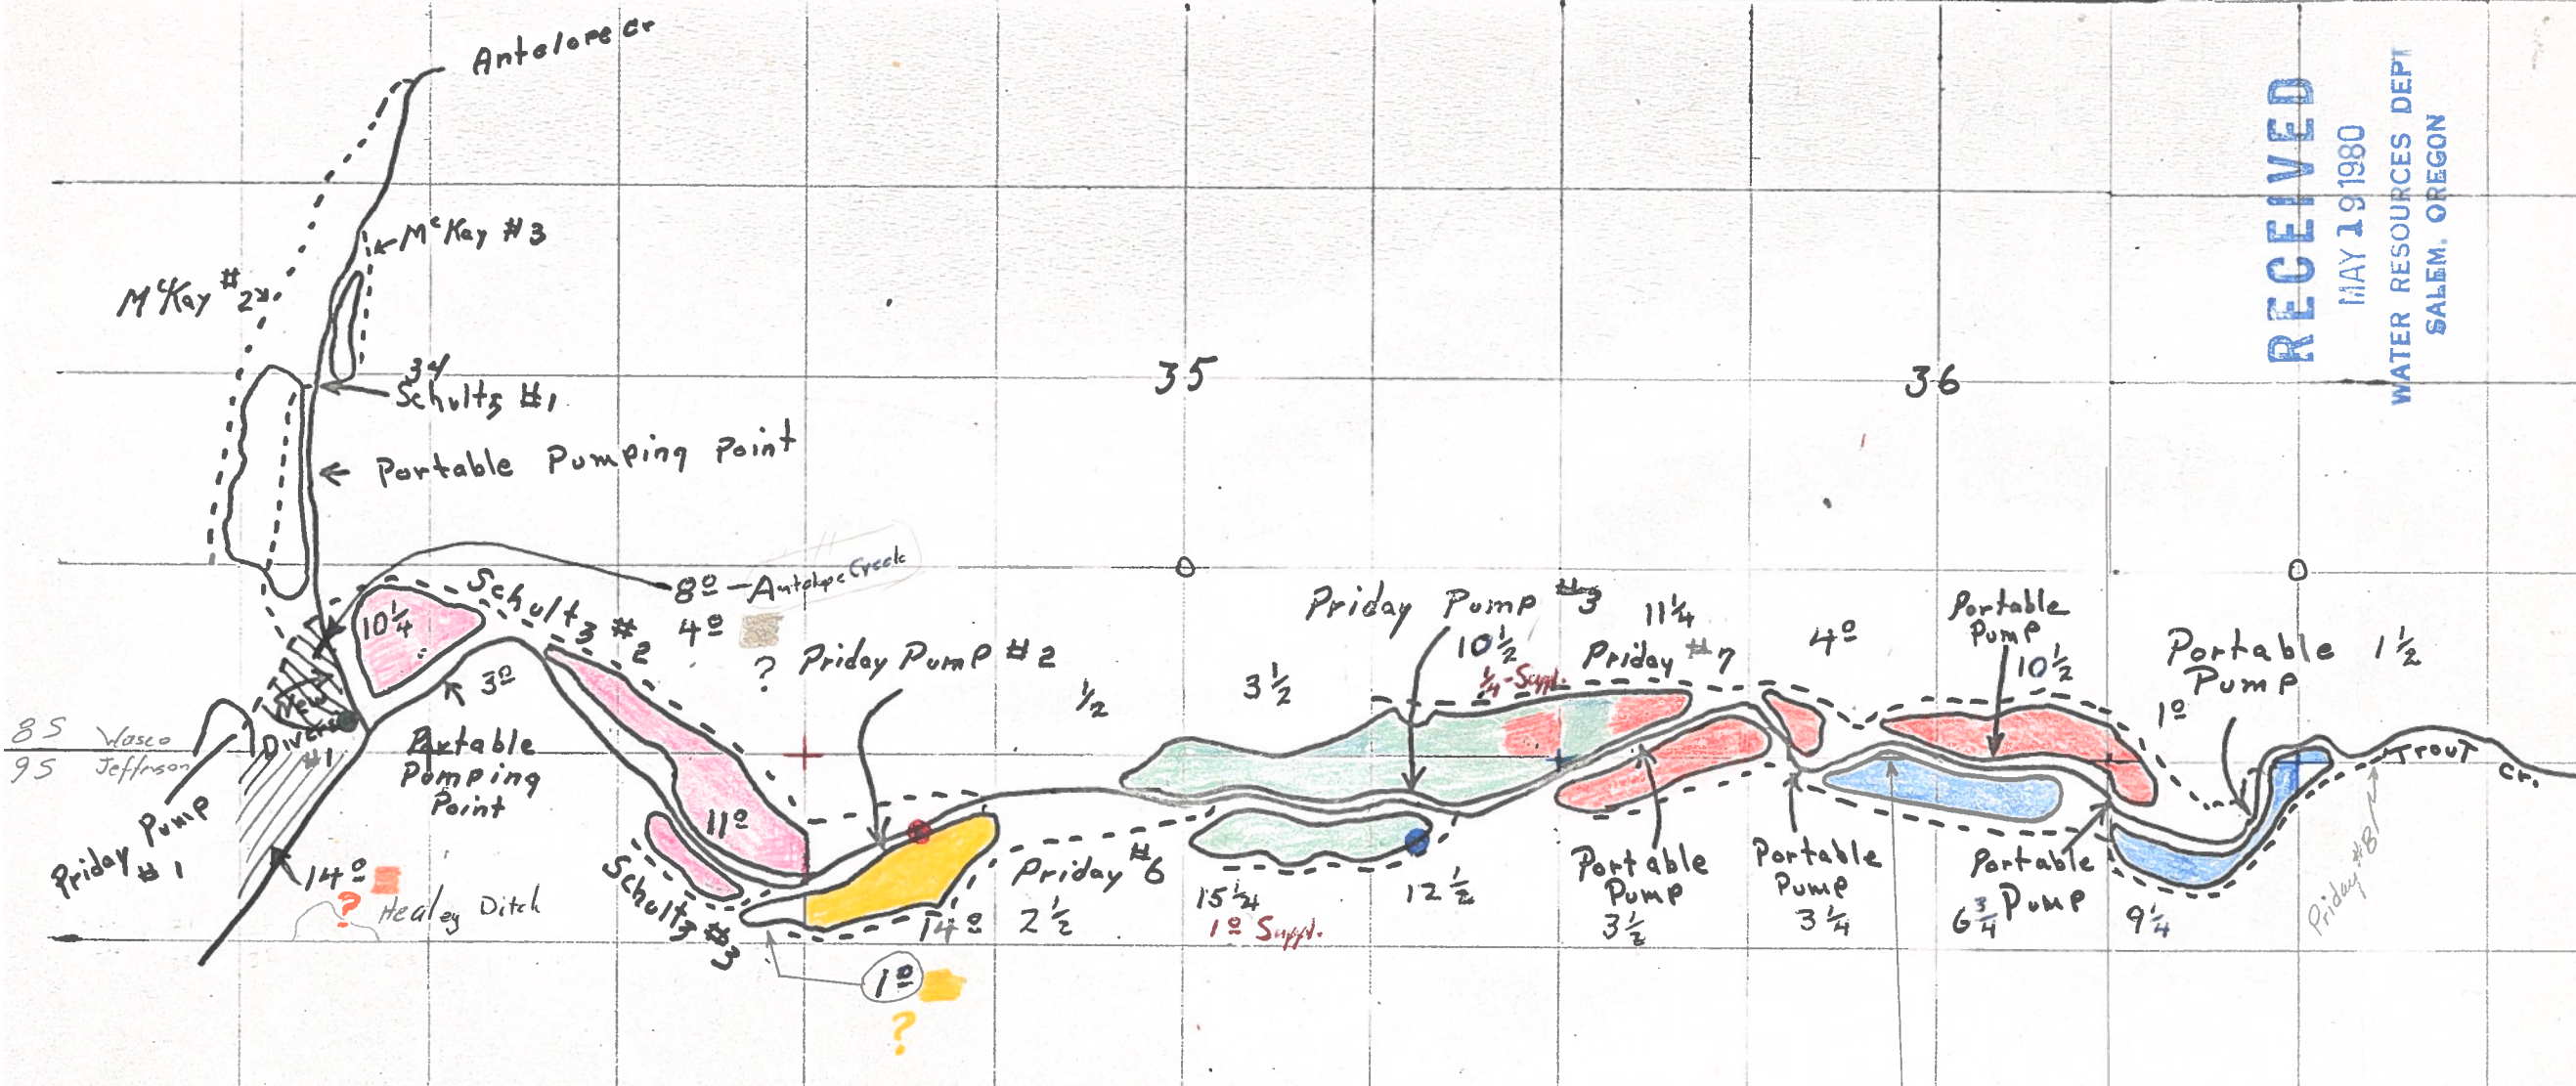

85 Wasco
95 Jefferson

- Antelope Creek - 3 Schultz #1
- Healey ditch
- Schultz & Trout Ck. ditches
- Trout Creek - Friend #6
- Nunn #7
- Friday #8
- Sam Douthitt ditch

See also
photo
DDU-6H-135