


RECEIVED

MAY 19 1980

WATER RESOURCES DEPT
SALEM, OREGON

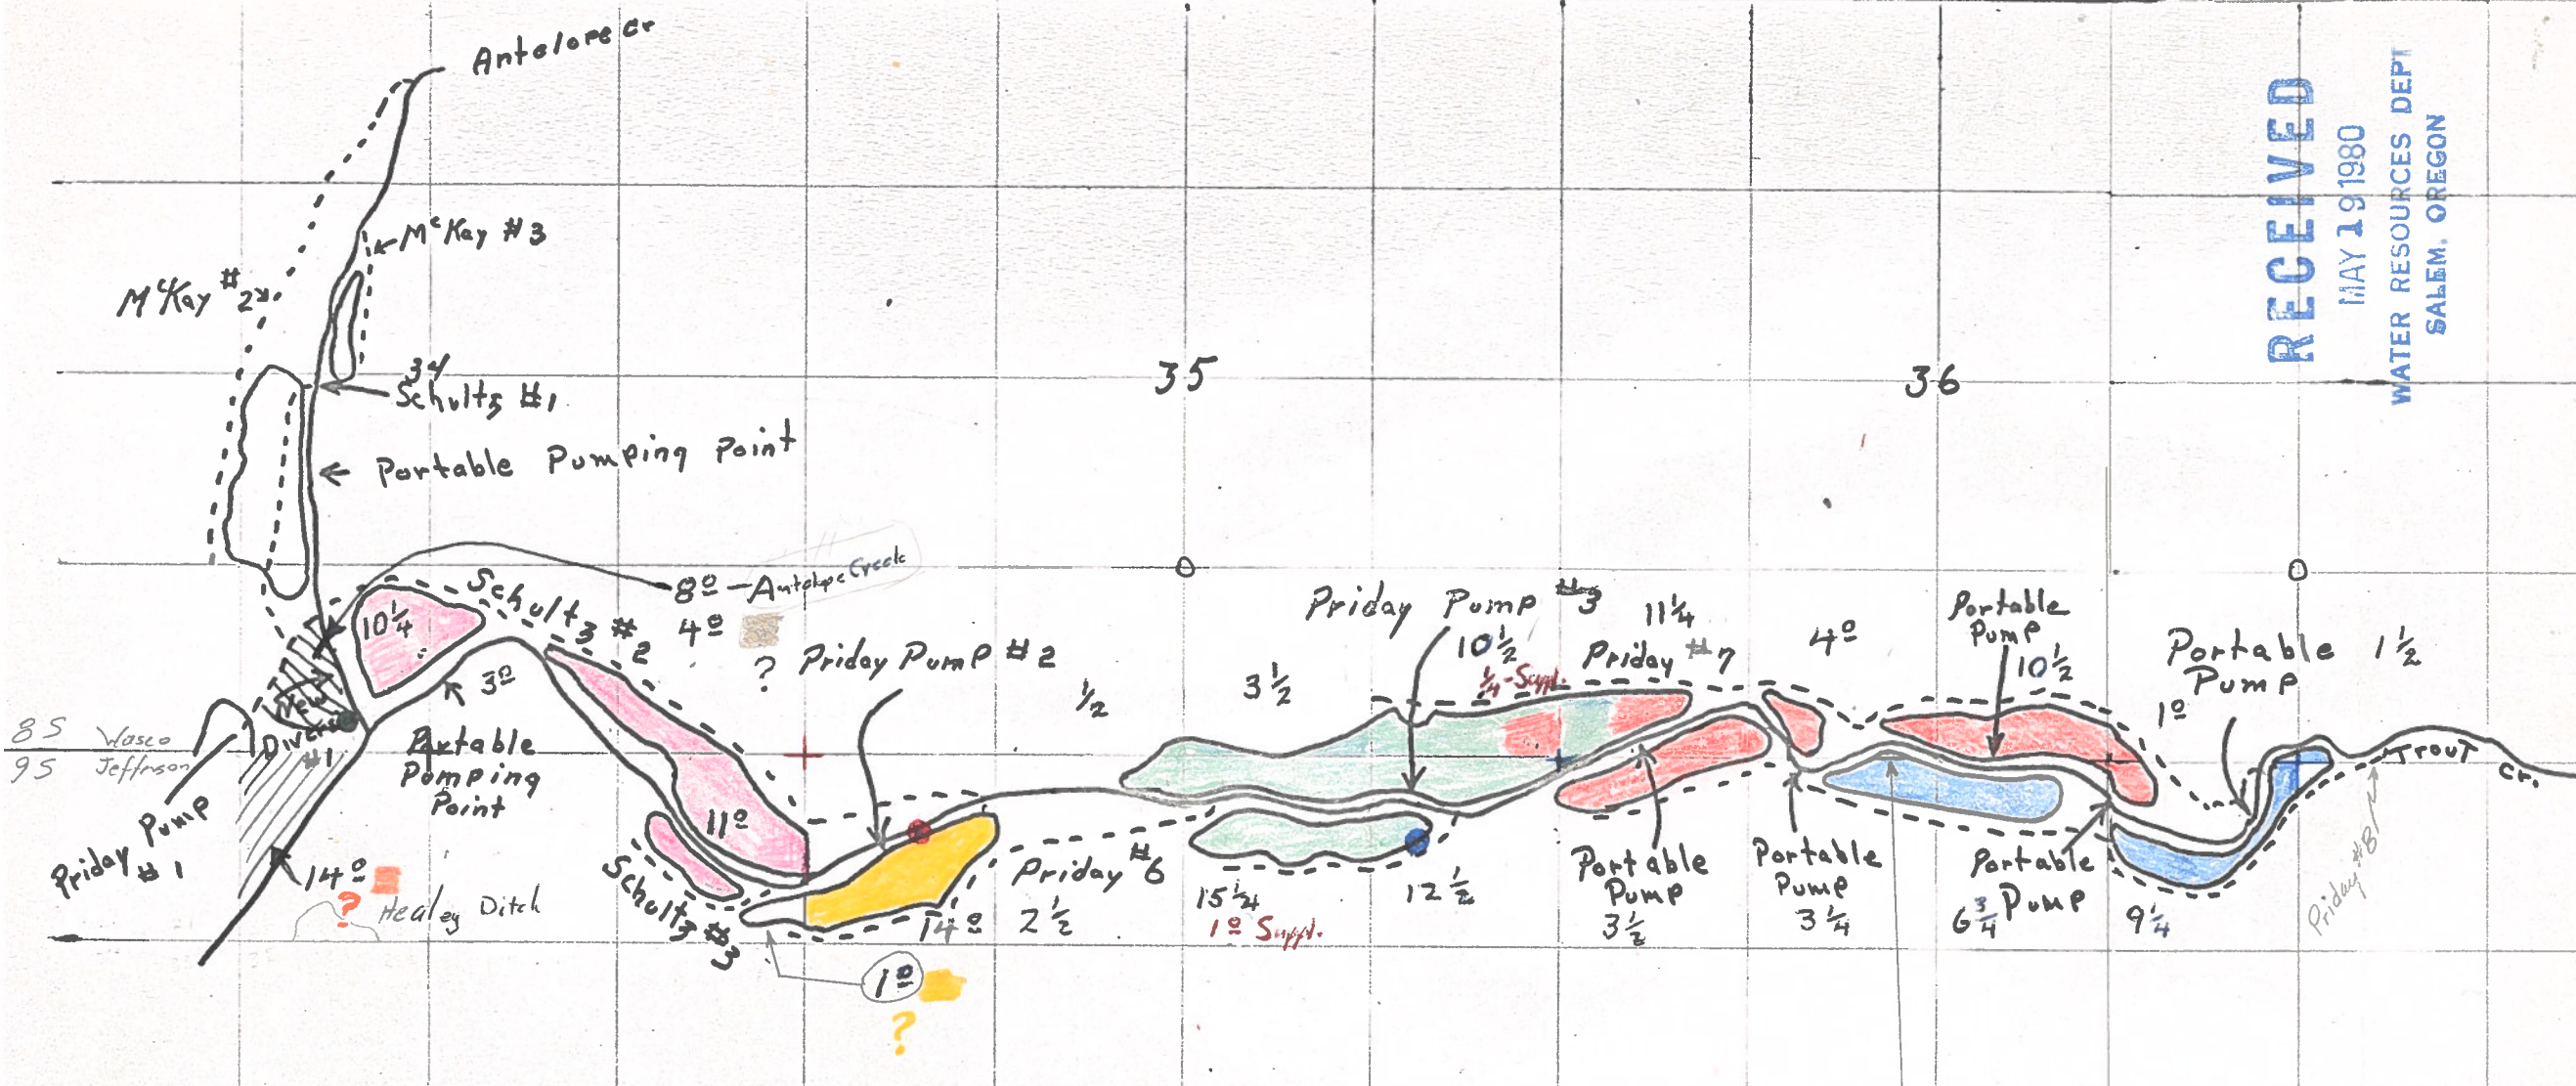

85 Wasco
95 Jefferson

- Antelope Creek — 3 Schultz #1
- Healey ditch
- Schultz & Trout Cr. ditches
- Friday #8
- Sam Douthitt ditch

See also
photo
DDU-6H-135

1/4 ?