

# **LEGEND** | DISCRIPTION | SYMBOLS | |-------------|---------| |-------------|---------|

|                      |              |
|----------------------|--------------|
| SECTION LINE         | —————        |
| QUARTER-QUARTER LINE | - - - - -    |
| TAX LOT LINE         | =====        |
| CREEK                | ~~~~~        |
| CANAL                | =====        |
| SECTION CORNER       | 30 31<br>1 6 |
| PUMP                 | ⊕            |



## **Certificates:**

|                         |  |
|-------------------------|--|
| Certificate 8377 (1886) |  |
| Certificate 8377 (1888) |  |
| Certificate 28157       |  |
| Certificate 44856       |  |

## **POINTS OF DIVERSION LOCATIONS**

Authorized POD: N25°E AND 2700' FROM THE N 1/4 CORNER SECTION 28, T28S., R.48 E., W.M.

Current POD 2795' NORTH AND 9220' EAST OF THE NE CORNER SECTION 28, T28S., R.48 E., W.M.

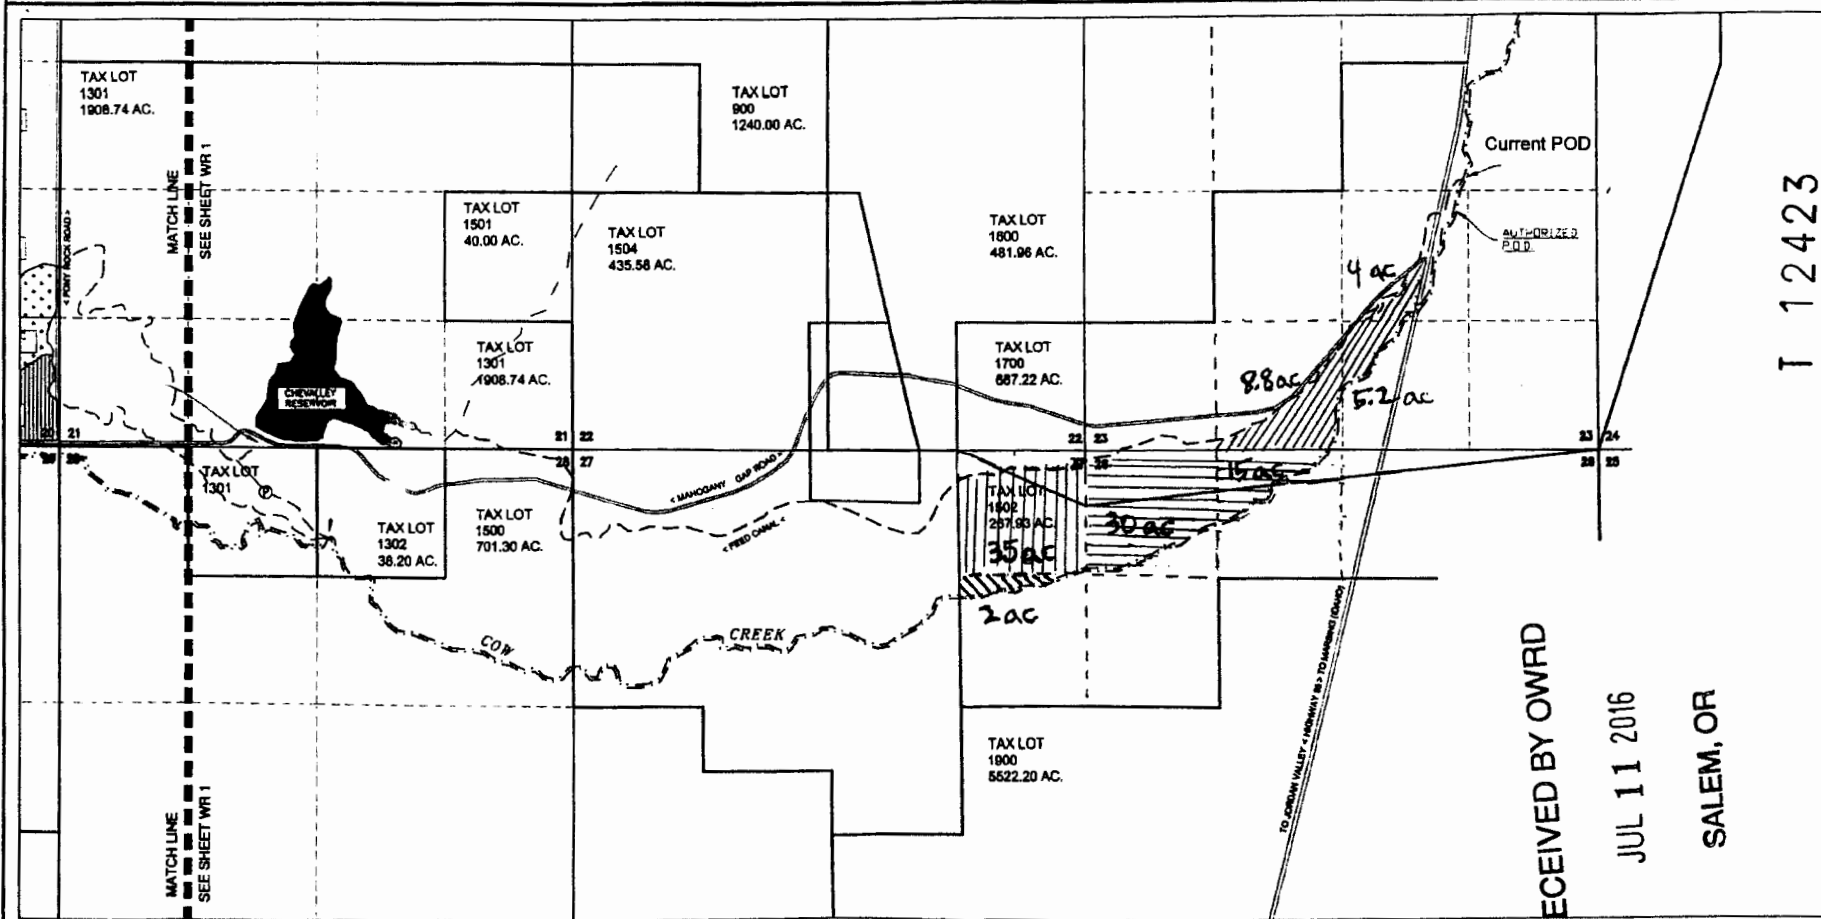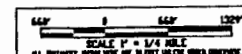


T 12423

RECEIVED BY OWRD  
JUL 11 2016  
SALEM, OR

Township 28 S , Range 46 E .

22-2-4

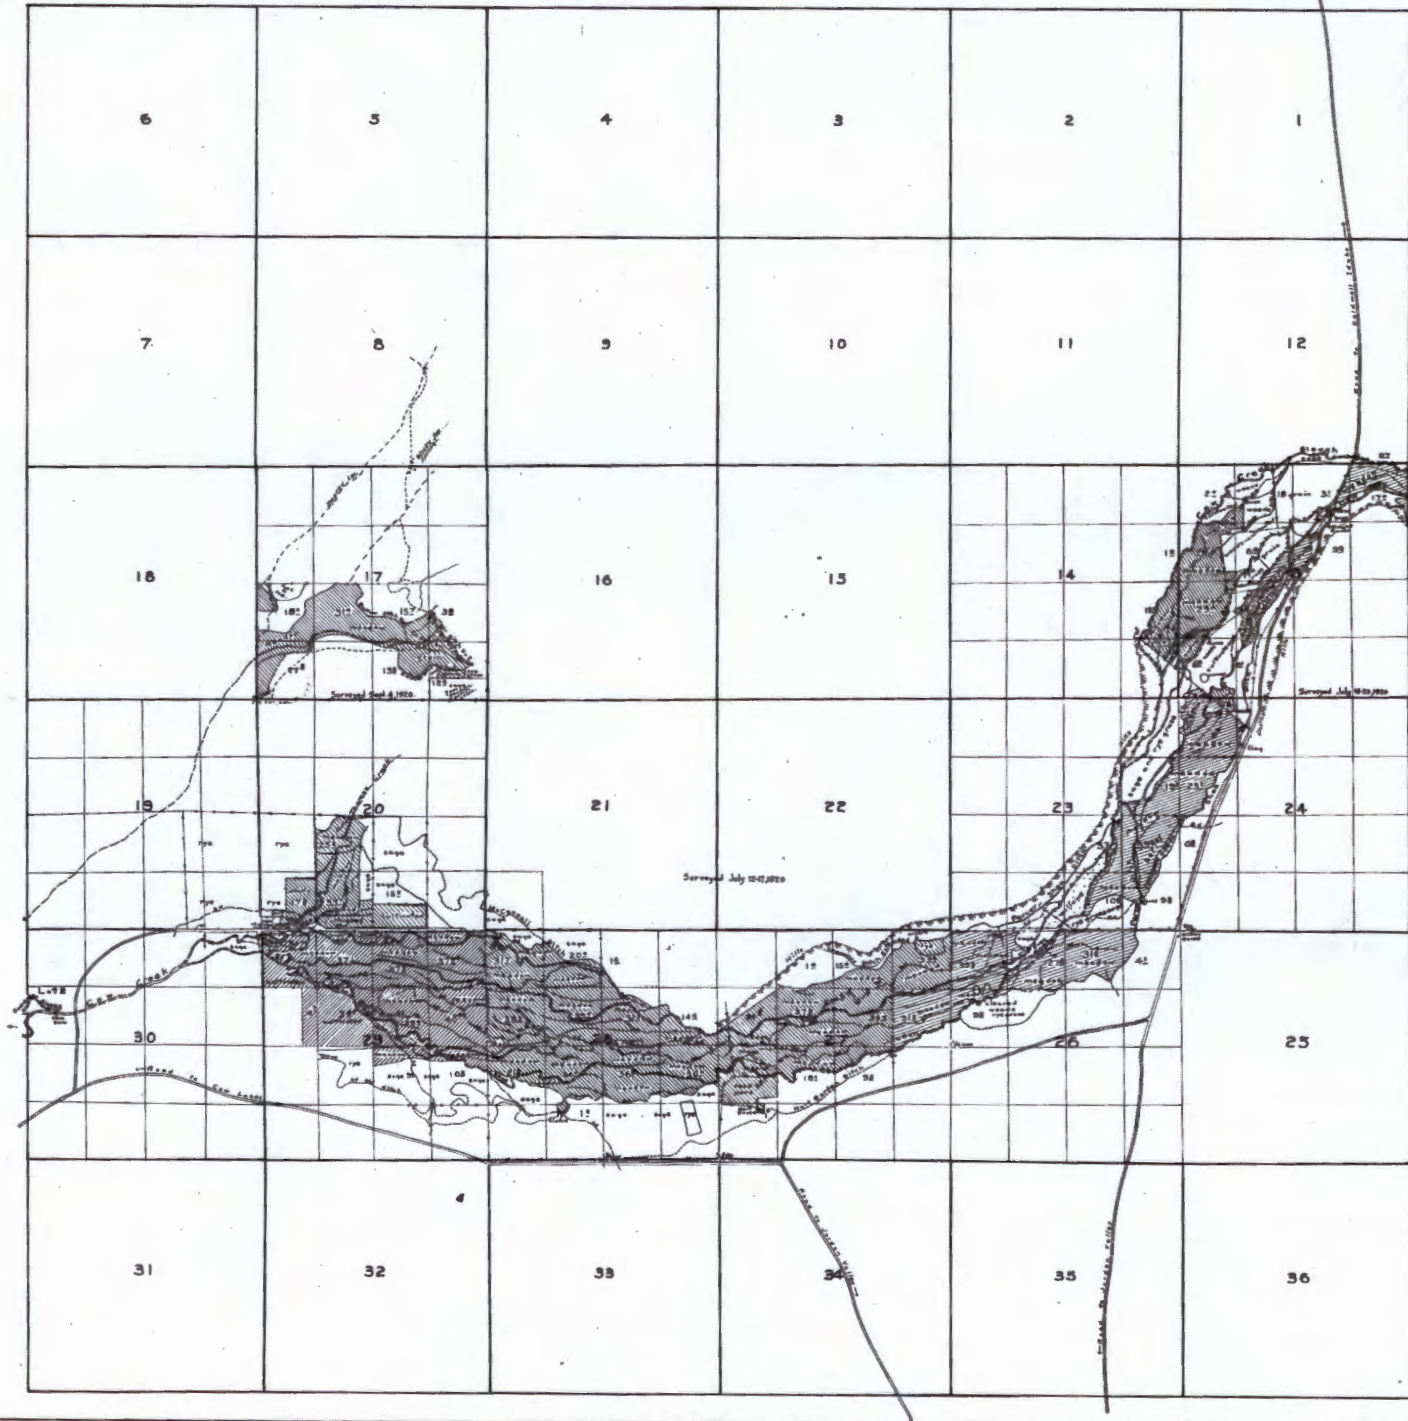

RECEIVED BY OMRD

JUL 11 2016

SALEM, OR


T 12423

RECEIVED BY OWRD

JUL 11 2015

SALEM, OR

22 T 12423

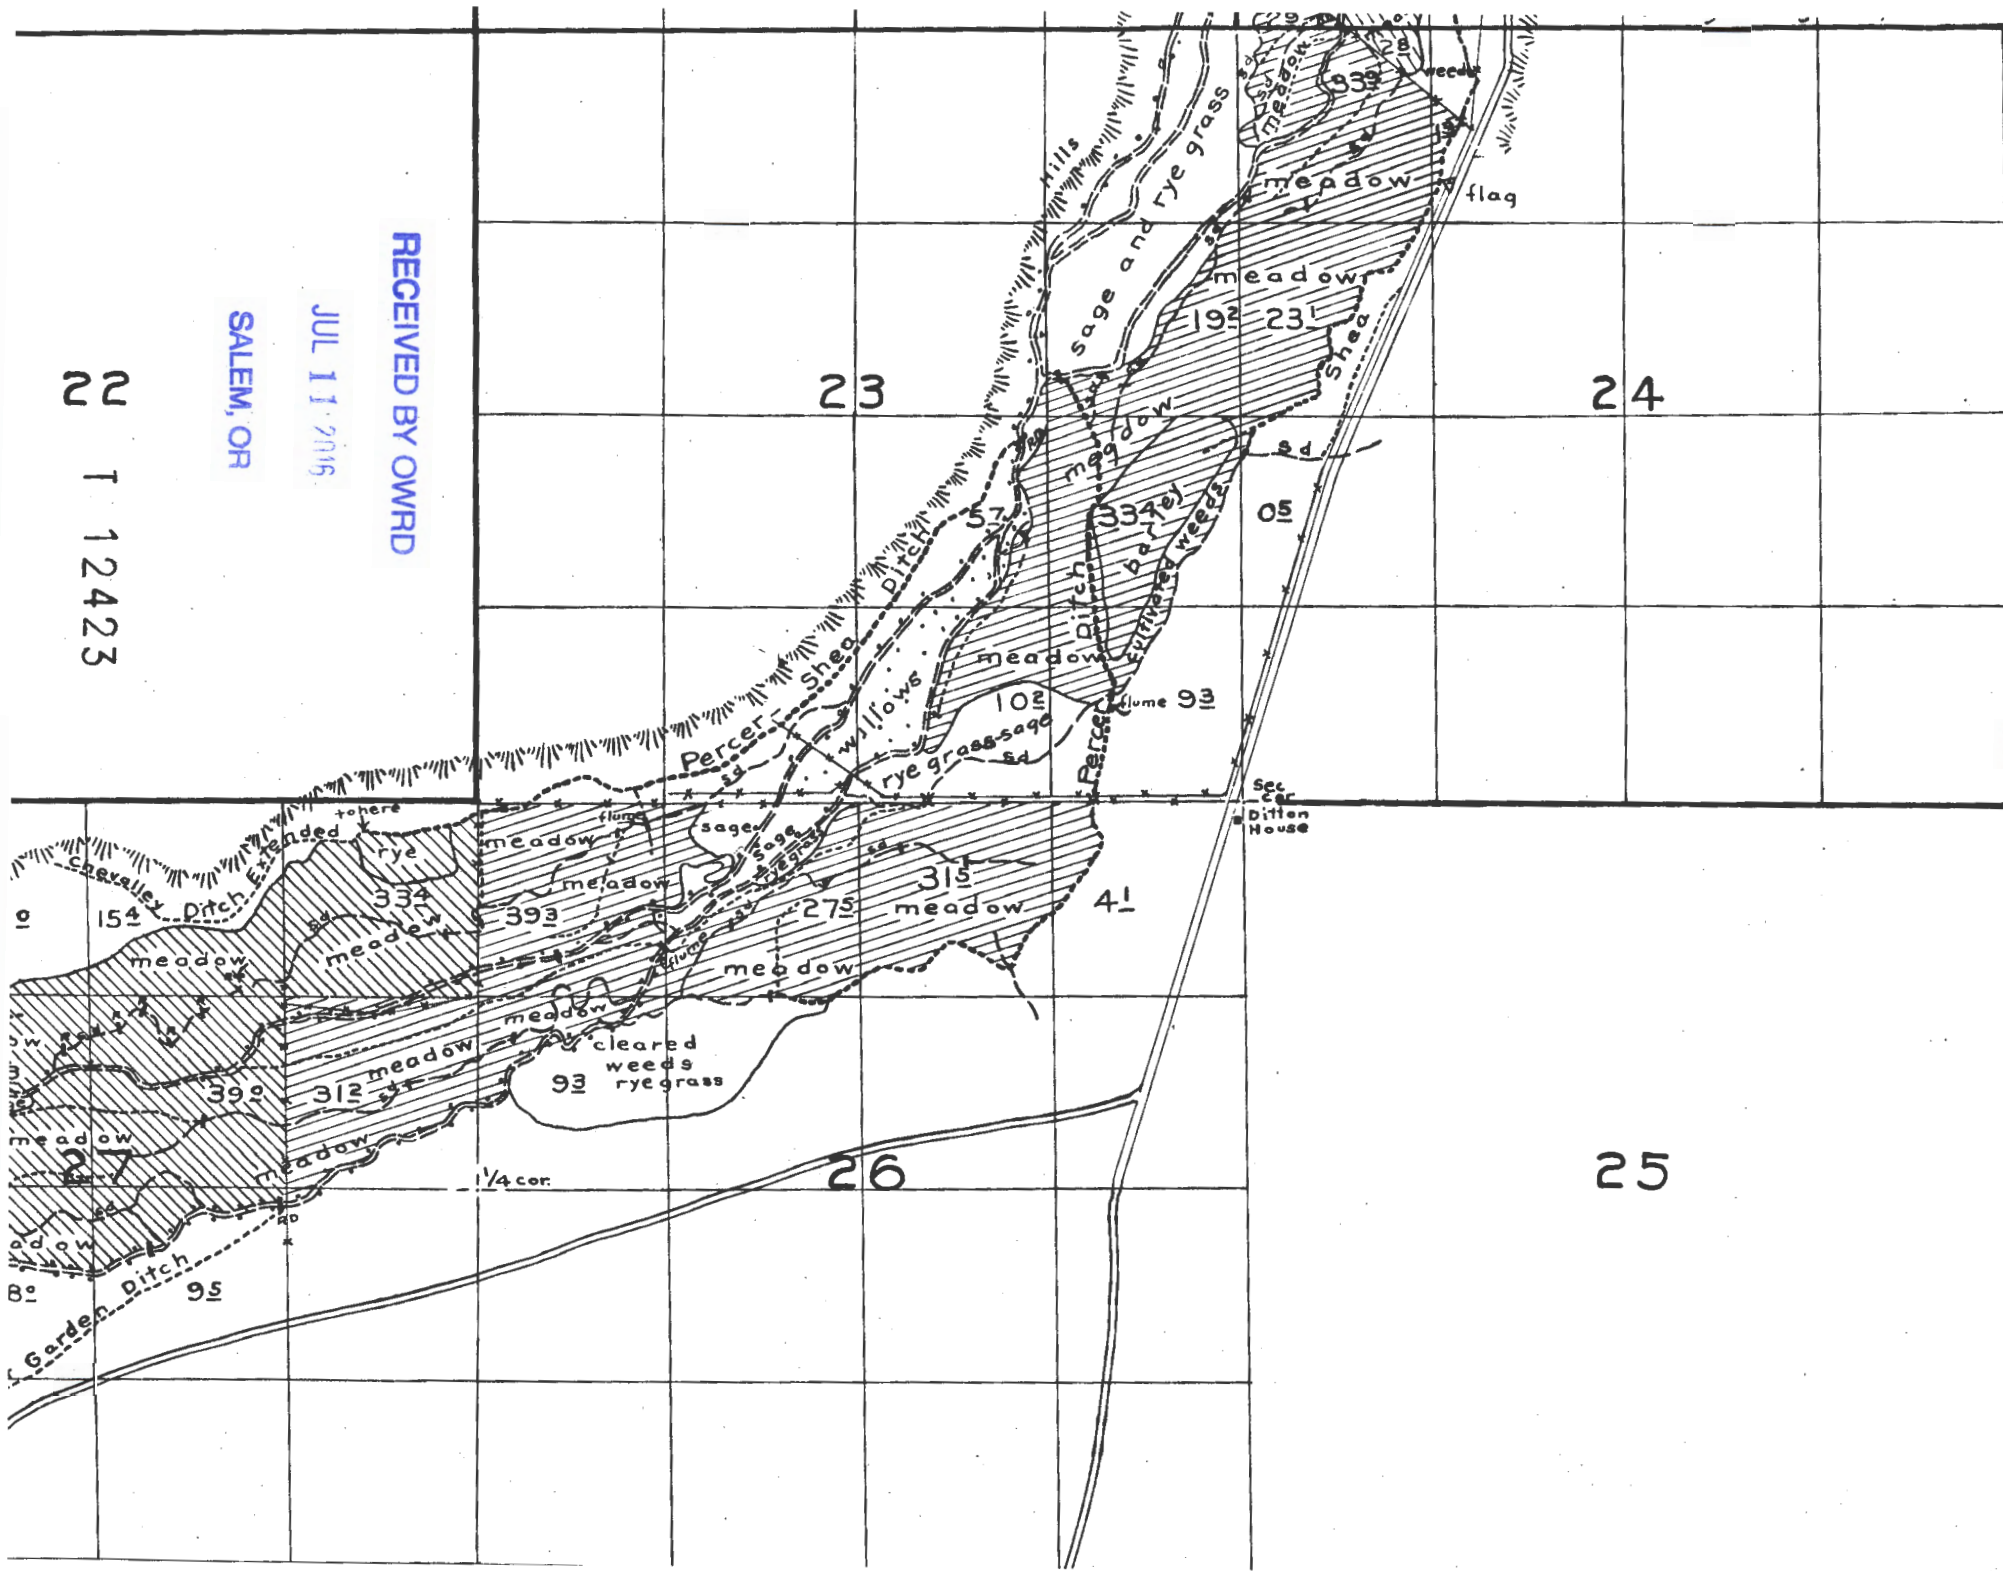

AC BRIDE, TIMOTHY S

AC BRIDE, TIMOTHY S

This point of diversion is not authorized.  
All users are using this POD.

This is the authorized "Feeder Canal POD"

Feeder Canal

Feeder Canal

BALTZOR CATTLE CO

BALTZOR CATTLE CO

BALTZOR CATTLE CO INC

BALTZOR CATTLE CO INC

BALTZOR CATTLE CO

BALTZOR CATTLE CO

LR RANCH, LLC

LR RANCH, LLC

SALEM, OR

RECEIVED BY OWRD

JUL 11 2016

T 12423

BM

Stearns Reservoir

Cow Spring

Purser Spring

Elk Cow Cr  
5.6Ac

C-44857 (Date) 1965  
See Cert  
Elk Gate Cr  
0.1Ac

C-44857 (Date) 1965  
See Cert  
Elk Gate Cr  
4.6Ac

C-44857 (Date) 1965  
See Cert  
Elk Gate Cr  
12.0Ac

C-44857 (Date) 1965  
See Cert  
Elk Gate Cr  
2.6Ac

C-8377 (Date) 1885  
Shea  
Cow Cr  
15.0Ac

C-8377 (Date) 1885  
Shea  
Cow Cr  
36.0Ac

C-8377 (Date) 1885  
Shea  
Cow Cr  
25.0Ac

C-8377 (Date) 1885  
Shea  
Cow Cr  
25.0Ac

