


# Permanent Water Right Transfer for Sonnen

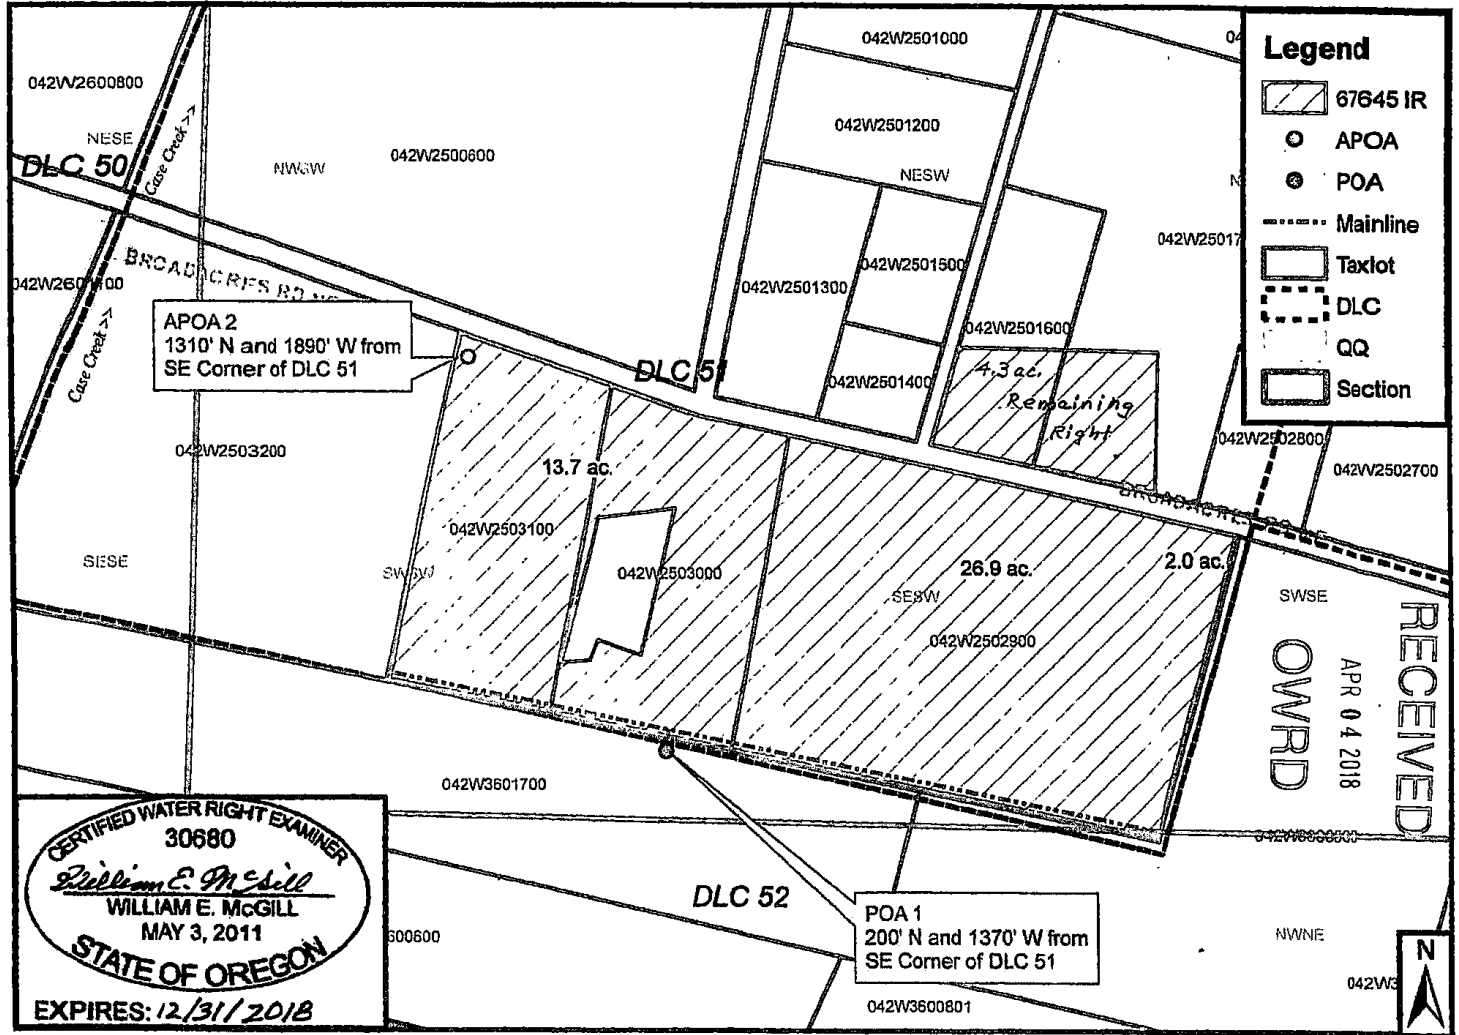

**Legend**

- 67645 IR
- APOA
- POA
- Mainline
- Taxlot
- DLC
- QQ
- Section

APOA 2  
1310' N and 1890' W from  
SE Corner of DLC 51

POA 1  
200' N and 1370' W from  
SE Corner of DLC 51

RECEIVED  
 APR 04 2018  
 OWRPD

CERTIFIED WATER RIGHT EXAMINER  
 30680  
*William E. McGill*  
 WILLIAM E. MCGILL  
 MAY 3, 2011  
 STATE OF OREGON  
 EXPIRES: 12/31/2018

0 400 800 Feet

