

**T25S, R32.5E,
SECTION 2, WM**

HARNEY COUNTY, OREGON

RECEIVED BY OWRD

DEC 21 2017

SALEM, OR




0 1,320 Feet


1" = 1,320'

-  POU Irrigation
-  Township
-  Section
-  Quarter Quarter
-  Tax lot
-  Well
-  Meter

WELL LOCATION:
1,430' N, 1,230' W OF C1/4 COR SEC 2

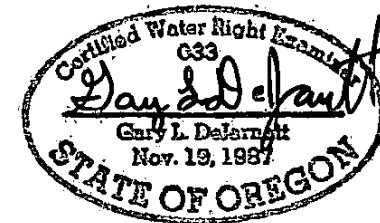

RENEWAL DATE 12/31/2017

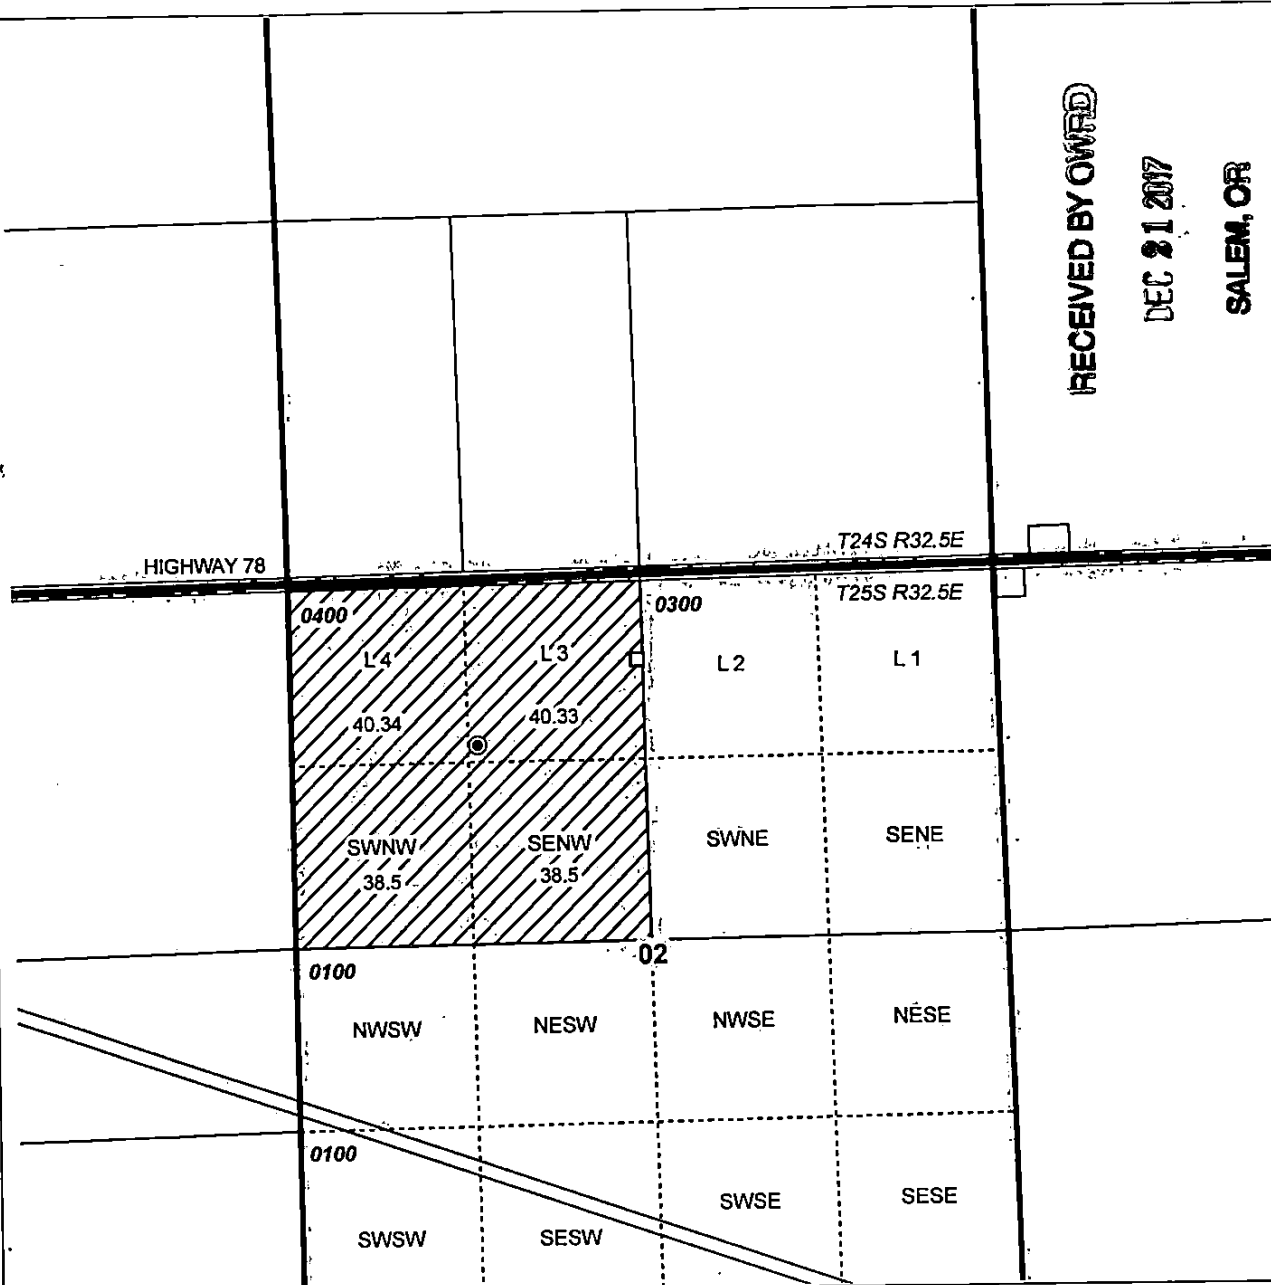

CLAIM OF BENEFICIAL USE
Dave Miller

NOTE: THIS MAP IS NOT INTENDED TO
PROVIDE LEGAL DIMENSIONS OR LOCATIONS
OF PROPERTY OWNERSHIP LINES.

WATER RIGHT SERVICES, LLC

PO BOX 1830, BEND, OR 97709

CCB# 197121 www.oregonwater.us

541-389-2837 JOHNSHORT@USA.COM

AP G-17131

PERMIT G-16670

PROJECT #17046

DECEMBER 19, 2017