


**T22S, R03W
SECTIONS 17 & 18, WM**


LANE COUNTY, OREGON

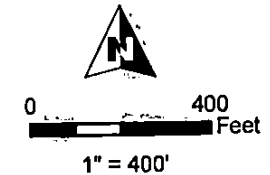


- POU IR & IS
- Section
- Tax Lot
- Quarter Quarter
- DLC Boundary
- DLC Corner
- Point of Diversion

POD # 1 & 2 WITH METER:
65' N, 405' E OF SW COR DLC 43

RECEIVED BY OWRD
NOV 09 2017
SALEM, OR

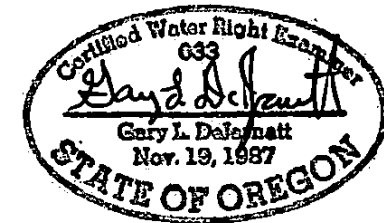

RENEWAL DATE 12/31/2017

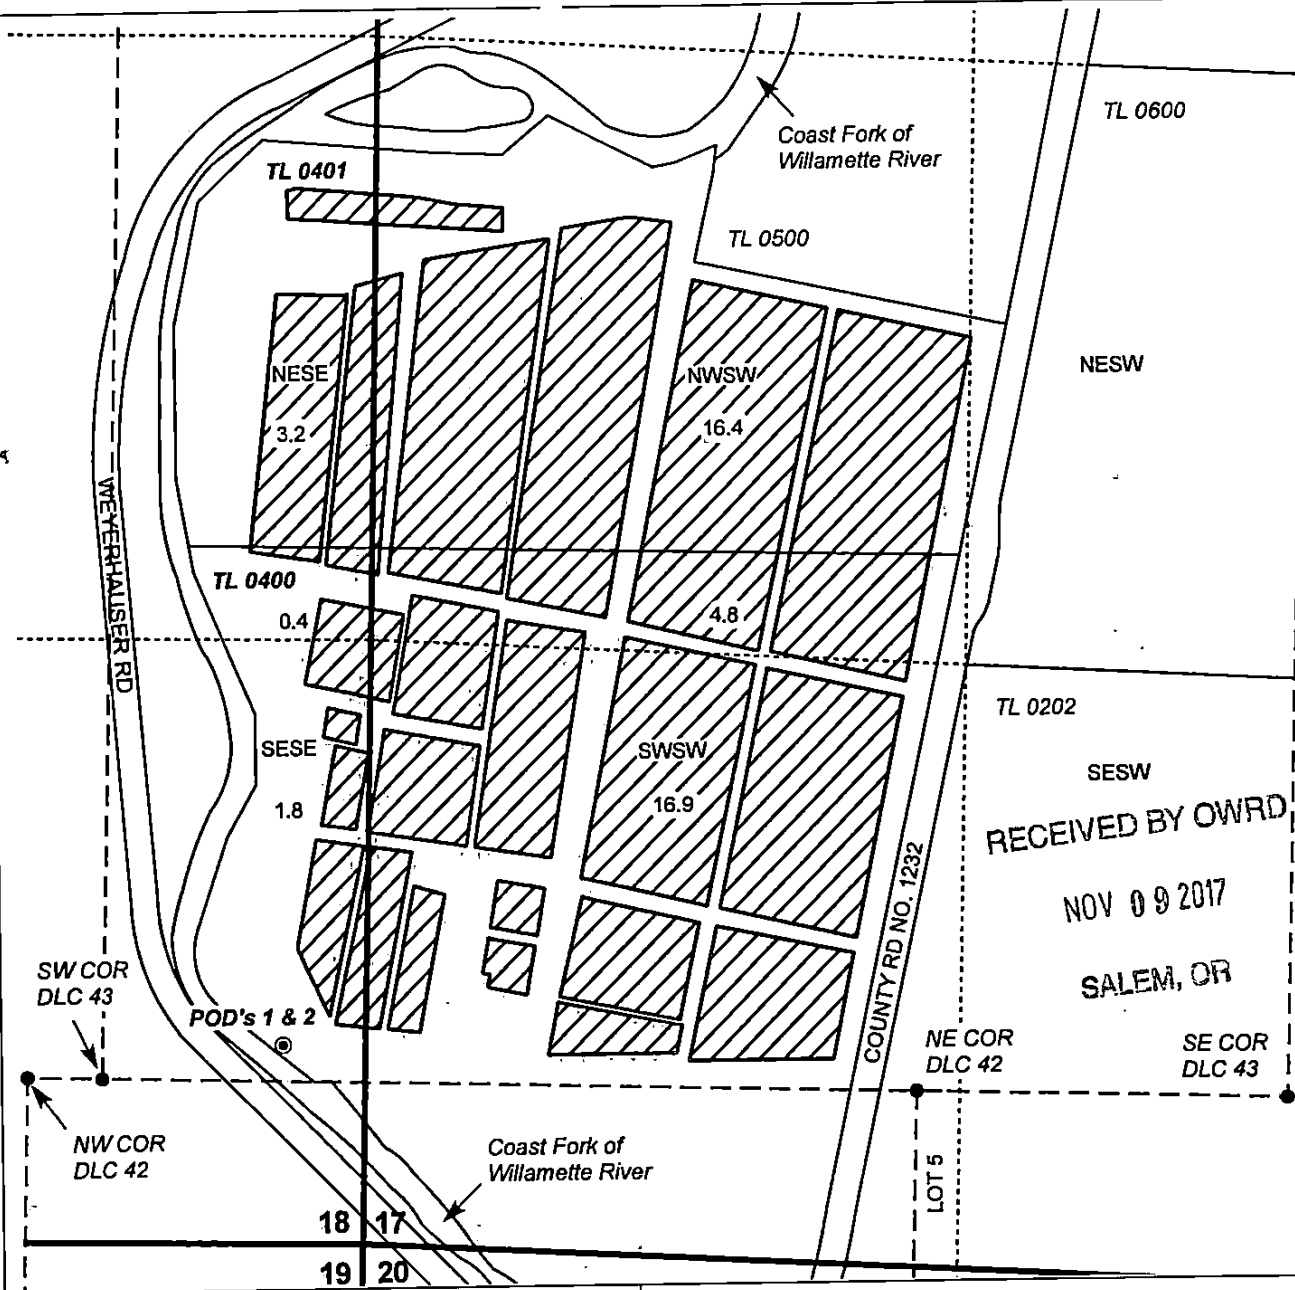

CLAIM OF BENEFICIAL USE MAP

Tom & Julie Johns

TRANSFER T-12315

NOTE: THIS MAP IS NOT INTENDED TO
PROVIDE LEGAL DIMENSIONS OR LOCATIONS
OF PROPERTY OWNERSHIP LINES.

JOB # 17052

OCTOBER 20, 2017

WATER RIGHT SERVICES, LLC

PO BOX 1830, BEND, OR 97709

CCB# 197121 www.oregonwater.us

541-389-2837 JOHNSHORT@USA.COM