
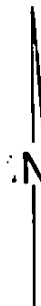


T.30S. R. 3W. W.M.

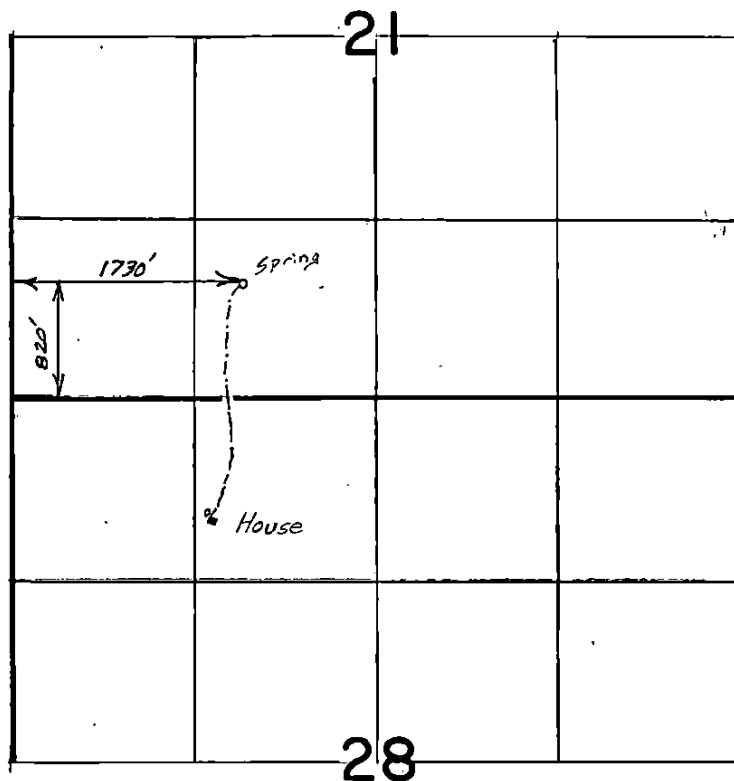

Scale 1"=1320'

FINAL PROOF SURVEY UNDER

Application No. 61629 Permit No. 45772
IN NAME OF

Surveyed Oct. 31, 2002 by S. DeHaas