


T. 30 S., R. 4 W., W.M.

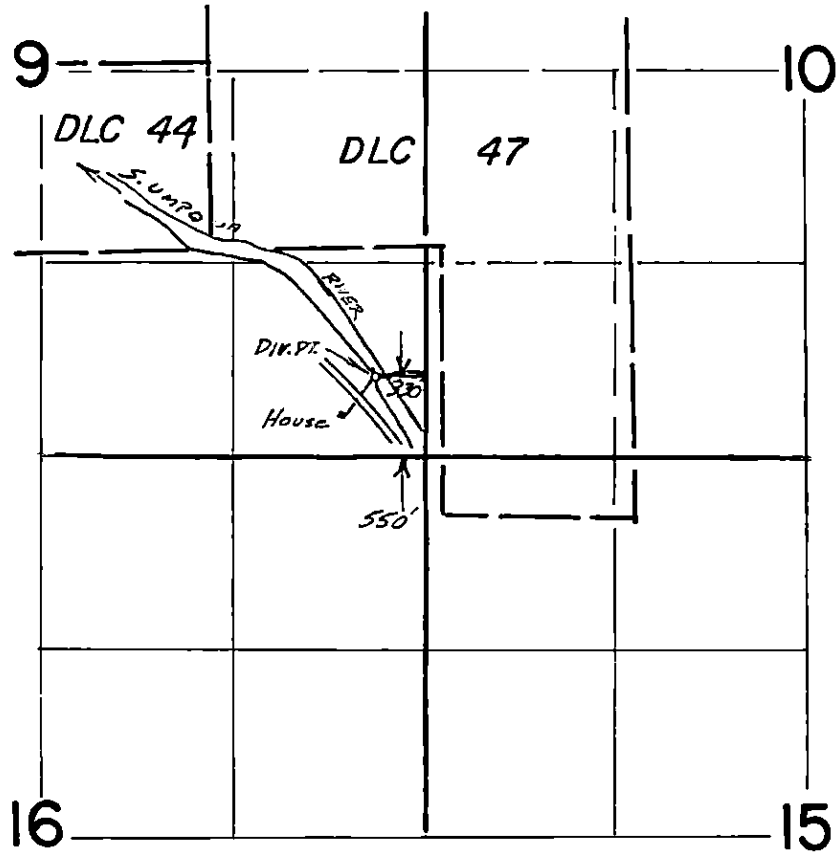

Scale 1" = 1320'

FINAL PROOF SURVEY
UNDER

Application No. 68259 Permit No. 49230...
IN NAME OF

HARRY L. CRAIG

Surveyed July 12, 1995, by L.M. SMITH...