


# T 24 S, R 32 E, WM

RECEIVED

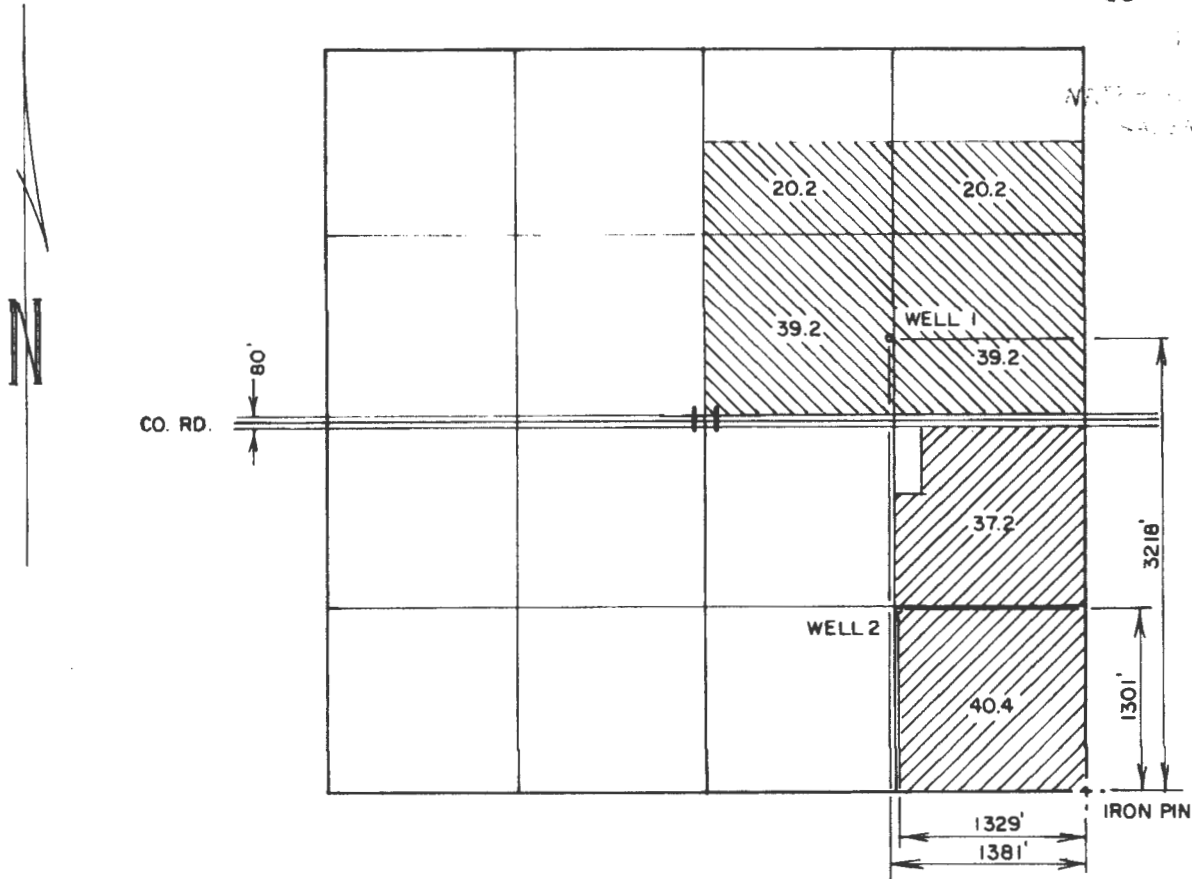

RECEIVED BY OWRD

JAN 10 2017

SALEM, OR

THE PURPOSE OF THIS MAP IS TO IDENTIFY THE LOCATION OF THE WATER RIGHT. IT IS NOT INTENDED TO PROVIDE INFORMATION RELATIVE TO THE LOCATION OF PROPERTY OWNERSHIP.

## FINAL PROOF SURVEY

UNDER APPLICATION G-12463  
PERMIT G-11785

IN THE NAME OF  
CURTIS J. BLACKBURN

Scale: 4" = 1 MILE

Date: JAN. 1996

Job: 1295

Dsn:

Drn: CHRIS


Ckd:



M. A. PALMER & SONS, INC.  
ENGINEERING & SURVEYING  
254 N. Alder - Box 61  
Burns, Oregon 97720



Sht. No.

of 1

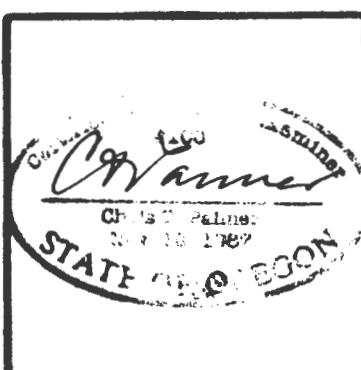





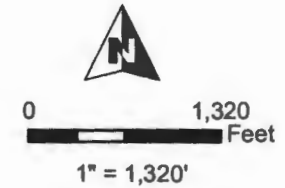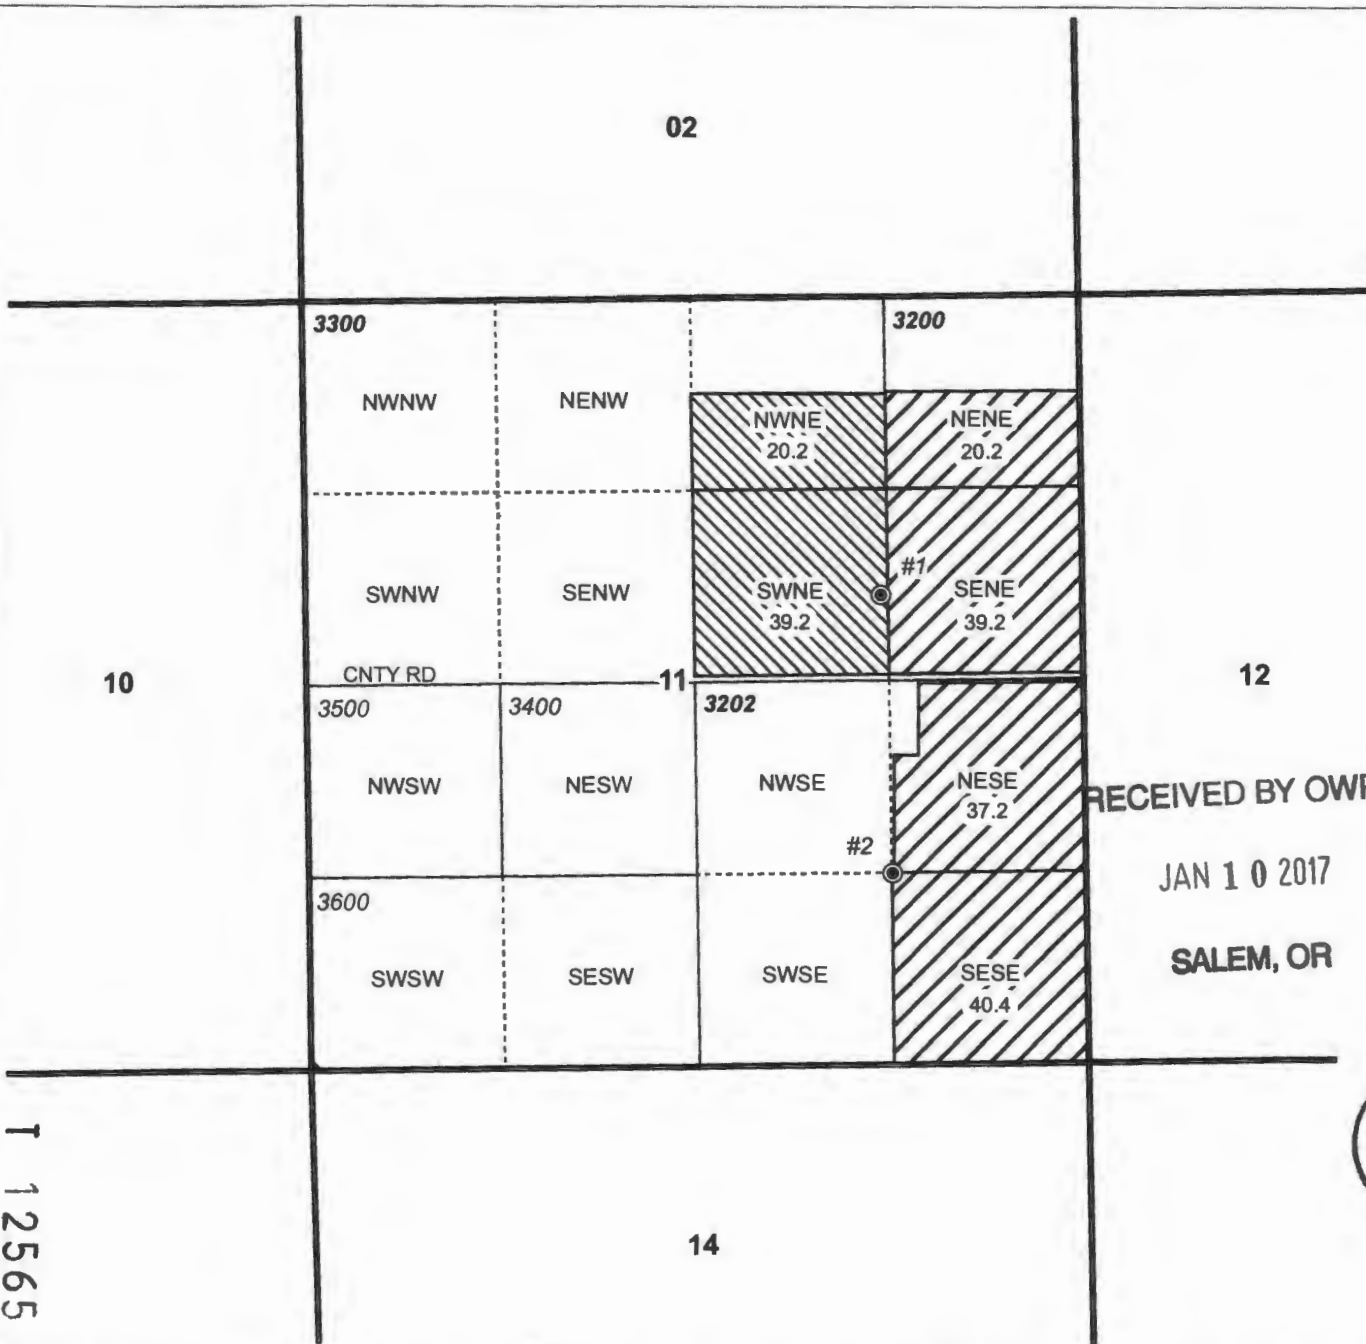

T 12565

**T24S, R32E,  
SECTION 11, WM**  
HARNEY COUNTY, OREGON



**POU Irrigation**

-  Transfer OFF
-  Remain ON
-  Section
-  Quarter Quarter
-  Tax Lot
-  Well

RECEIVED BY OWRD

JAN 10 2017

SALEM, OR

**WELL LOCATIONS:**

- #1: 3,218' N, 1,381' W OF SE COR SEC 11
- #2: 1,301' N, 1,329' W OF SE COR SEC 11



RENEWAL DATE 12/31/2018

**TRANSFER "OFF" MAP  
WEDEL RANCH**

CERTIFICATE 89916

NOTE: THIS MAP IS NOT INTENDED TO  
PROVIDE LEGAL DIMENSIONS OR LOCATIONS  
OF PROPERTY OWNERSHIP LINES.

JANUARY 4, 2017

**WATER RIGHT SERVICES, LLC**


PO BOX 1830, BEND, OR 97709

CCB# 197121 [www.oregonwater.us](http://www.oregonwater.us)





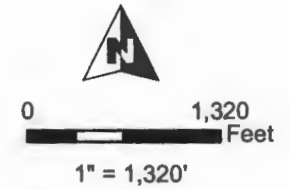


541-389-2837 [JOHNSHORT@USA.COM](mailto:JOHNSHORT@USA.COM)

T  
1  
2565

**T23S, R33E,  
SECTION 07, WM**  
HARNEY COUNTY, OREGON



**POU Irrigation**


-  Transfer ON
-  Township
-  Section
-  Quarter Quarter
-  Tax Lot
-  Well
-  Stream

WELL LOCATION:  
2,410' N, 870' E OF SW COR SEC 07


RECEIVED BY OWRD

JAN 10 2017

SALEM, OR

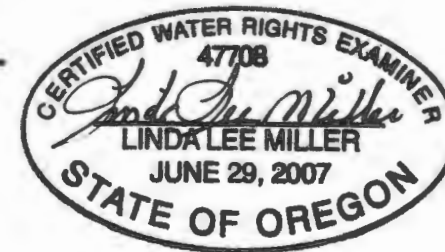

RENEWAL DATE 12/31/2018

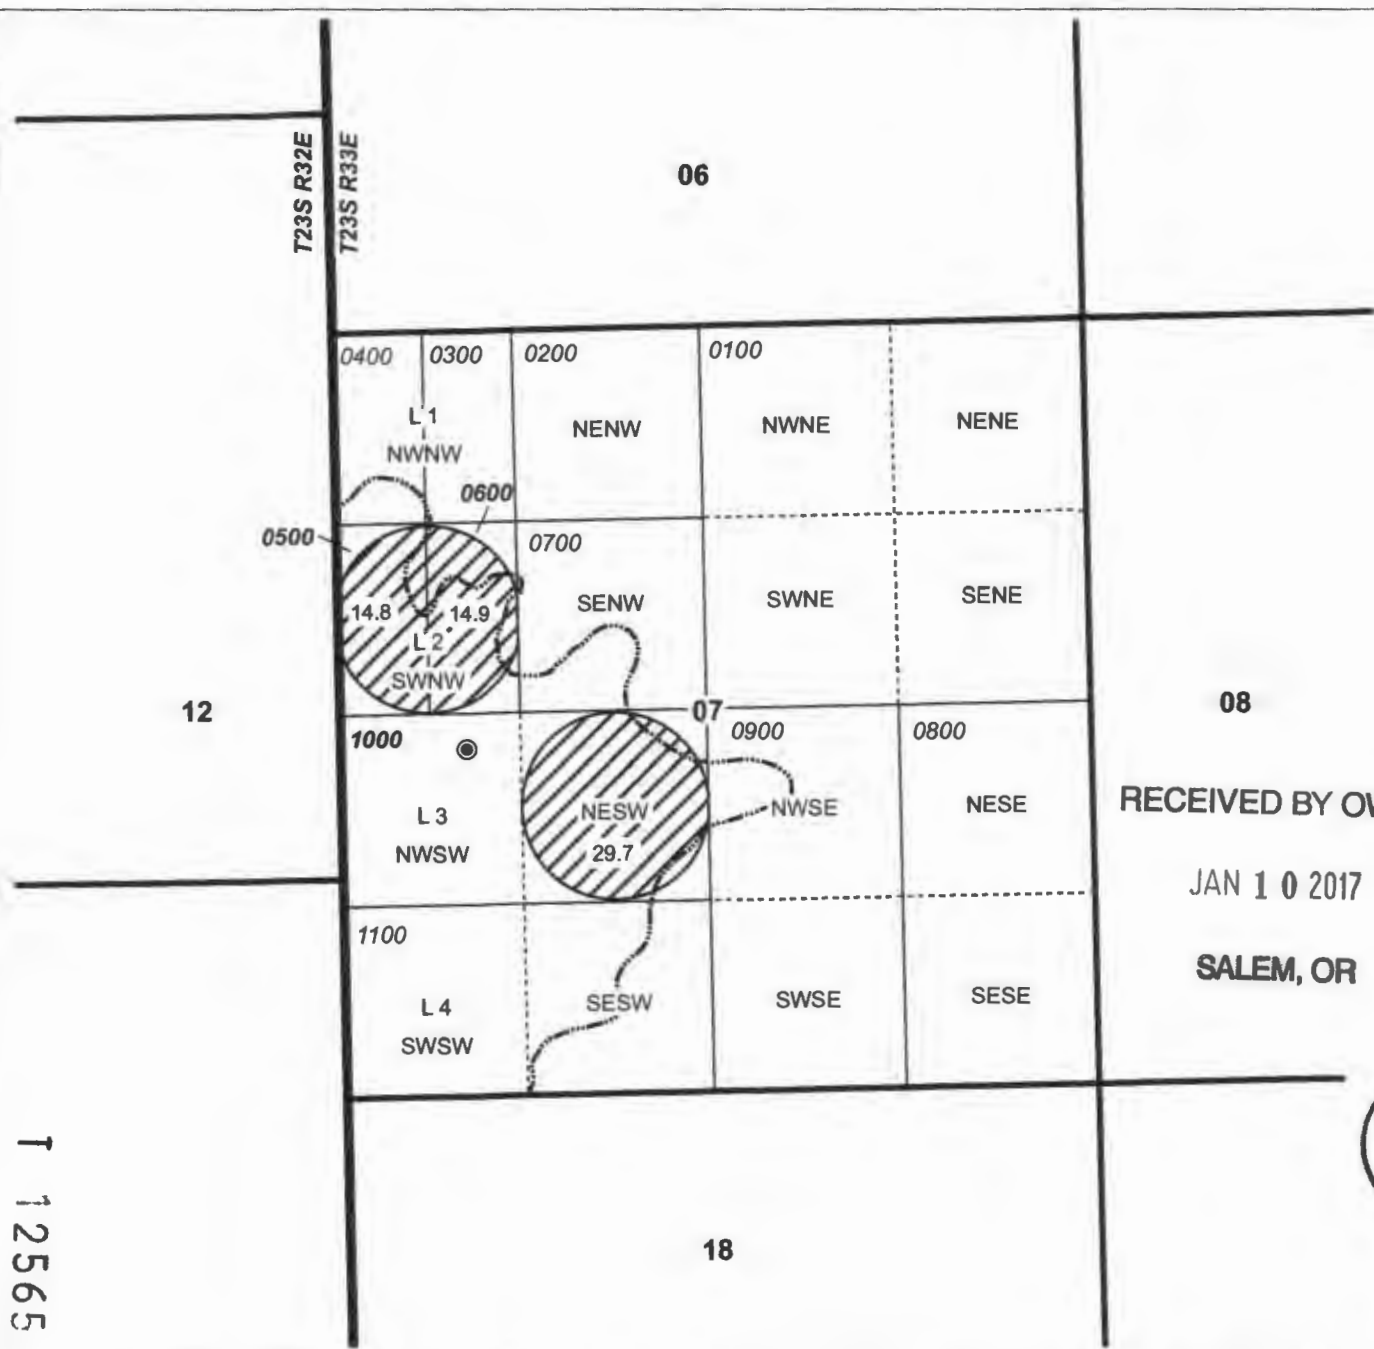

T 12565

**TRANSFER "ON" MAP  
WEDEL RANCH**

CERTIFICATE 89916

NOTE: THIS MAP IS NOT INTENDED TO  
PROVIDE LEGAL DIMENSIONS OR LOCATIONS  
OF PROPERTY OWNERSHIP LINES.

JANUARY 4, 2017

**WATER RIGHT SERVICES, LLC**

PO BOX 1830, BEND, OR 97709

CCB# 197121 [www.oregonwater.us](http://www.oregonwater.us)

541-389-2837 [JOHNSHORT@USA.COM](mailto:JOHNSHORT@USA.COM)