

#### NOTES



THE PURPOSE OF THIS MAP IS TO SHOW WATER RIGHT LOCATION AND AREAS BY 1/4 1/4 SECTION.

THIS MAP DOES NOT CONSTITUTE A BOUNDARY SURVEY.

THE TOTAL IRRIGATED AREA IS 178.8 AC.

THE POINT OF DIVERSION (POD1) IS LOCATED 580' SOUTH AND 490' WEST OF THE NE CORNER SECTION 31. AT THE POD1 IS A SUBMERSIBLE PUMP, BACKFLOW DEVICE, AND METER.

#### LEGEND

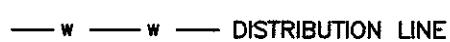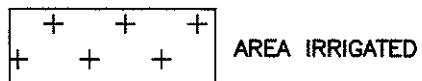

RECEIVED BY OWRD

JUN 04 2014

SALEM, OR




SCALE:  
1" = 400'

APPLICATION #G-14868  
PERMIT #G-13704

RENEWAL DATE: JUNE 30 2013

SITE\MISTFARM.DWG

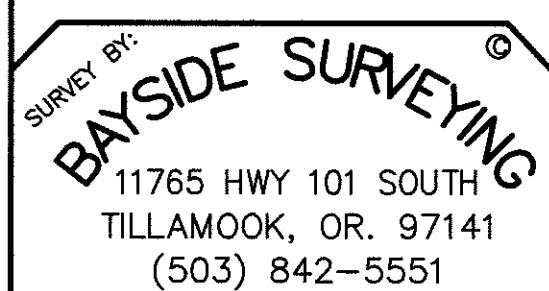

FINAL PROOF MAP FOR:  
**MISTVALE FARM**  
APPLICATION #G-14868, PERMIT #G-13704  
TAX LOT 100 SEC 31 &  
TAX LOTS 900, 801, & 600 SEC 32  
T1S, R9W, W.M.  
TILLAMOOK COUNTY, OREGON

DATE	EQUIPMENT	FIELD	DRAWN	CHECKED	JOB NO.
APRIL 23, 2014	TOPCON GPT-3003W TDS NOMAD	TLJ/DWE	DWE	TLJ	