


T. 40 S., R. 19 E., W.M.

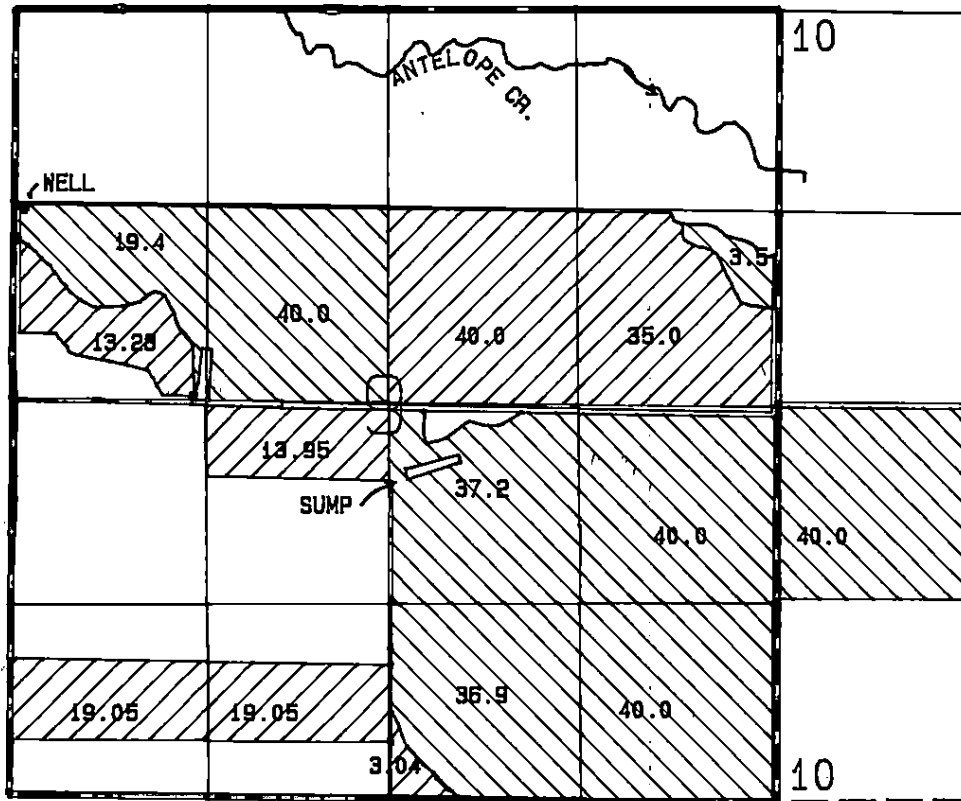

WELL LOCATED 1340 FT. S. AND 60 FT. E. FROM N.W. COR. 9

SCALE: 1 IN. = 1320

FINAL PROOF SURVEY

UNDER

Application No. G-8852 Permit No. G-8840

IN NAME OF

WILLIAM HOFFMAN

Surveyed Oct. 19, 1987 By B.S. JAMES

Photo: 379 96L DLM



PRIM.



SUPP.