


728

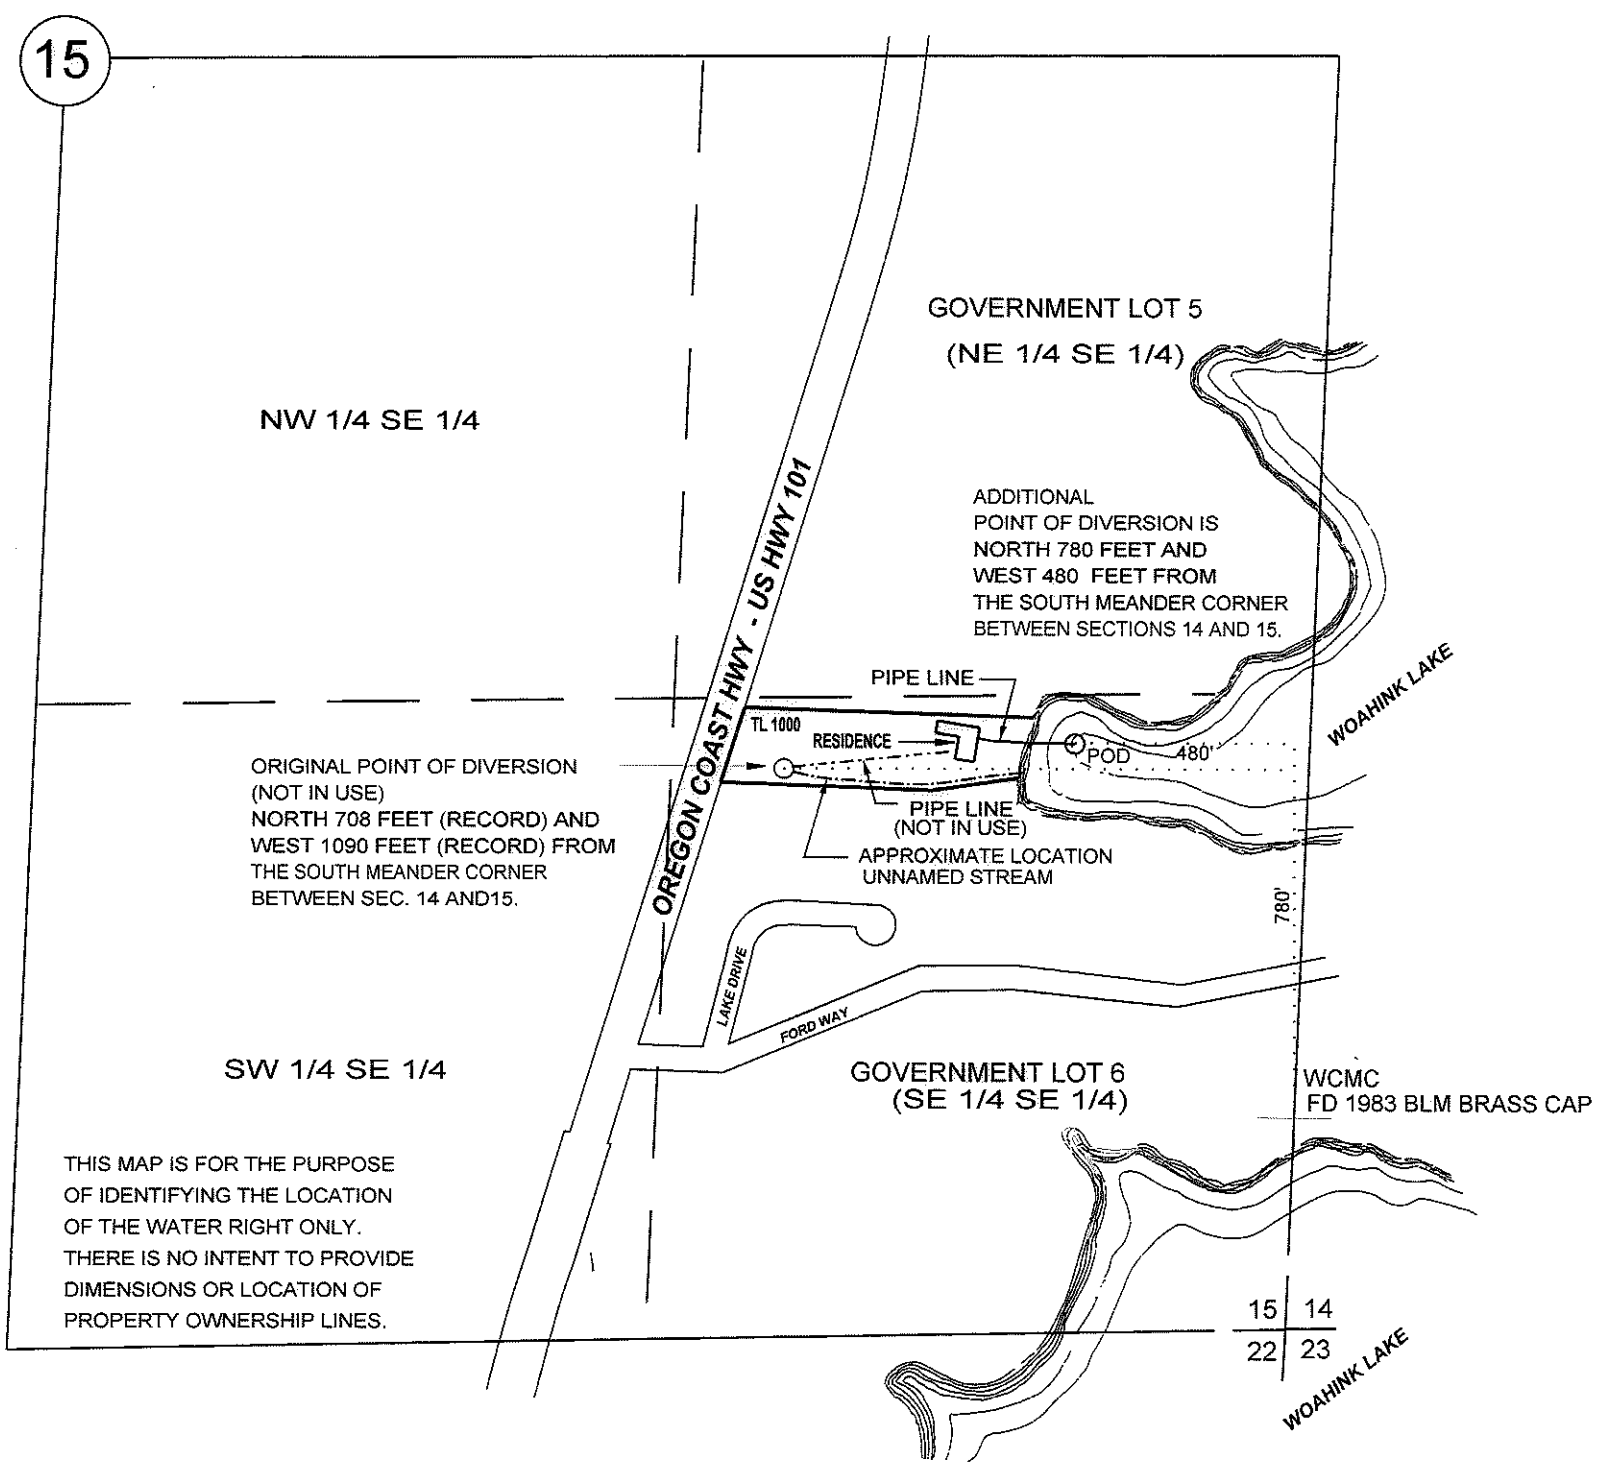


**CLAIM OF BENEFICIAL USE
WATER RIGHTS MAP**

MID COAST BASIN
TRANSFER NO. T-9475
UNDER
PERMIT 26957
APPLICATION NO. S 34227
CERTIFICATE NO. S 30291

MAP 19-12-15-4, TL 1000
SE 1/4 SE 1/4, SEC. 15, T19S, R12W, W.M.
LANE COUNTY, OREGON

FOR: RANDY AND HILDY BOESPFLUG
P.O. BOX 30000
FLORENCE, OREGON 97439

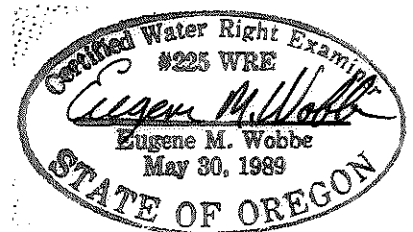

RECEIVED BY OWRD

PREPARED BY: WOBBE & ASSOCIATES, INC.
510 KINGWOOD ST. / P.O. BOX 3093
FLORENCE, OR 97439
DATE: OCTOBER 30, 2012

NOV 06 2012

SALEM, OR

COBU MAP # 728