

CORBU MAP # 0289

FINAL PROOF SURVEY

UNDER APPLICATION No. G-15167, PERMIT No. G-15052
LOCATED IN SECTION 22, T5S, R4W, WM.
YAMHILL COUNTY, OREGON

FOR:
AMITY HILLS LLC
P.O. BOX 3989
NAPA, CA 94558



16 15
21 22

NE COR
DLC 71

NW COR
DLC 72

LOT 1

LOT 2

TL 205

1365'

SE NW

SW NE

TL 204

3.8 AC

WELL #2

TANKS

4.9 AC

21.8 AC

NW SW
3.1 AC

13.2 AC

NE SW

NW SE

RECEIVED
SEP 26 2007
WATER RESOURCES DEPT
SALEM OREGON

TL 200

WELL #1

0.86 AC

SW COR
DLC 72


1470'

SE SW

570'

0.3 AC

SW SE

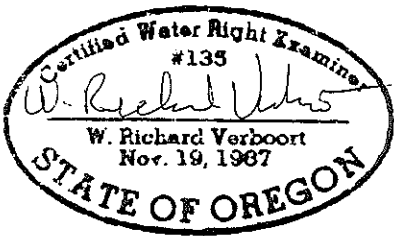

MAP IS BASED ON ASSESSORS
MAP & FSA PHOTO.



IRRIGATED AREA



IRRIGATION PIPE

400 0 200 400



1 inch = 400 ft.



ENGINEERING • LAND SURVEYING • FORESTRY
PLANNING • WATER RIGHTS

2137 19TH AVENUE FOREST GROVE, OR 97116
INFO@STUNTZNER.COM PHONE: (503) 357-5717 FAX: (503) 357-5698

DRAWN BY: C. VAN BUREN	DATE: 8-23-07
CHECKED BY: W.R. VERBOORT	DRAWING NO.: 3053012
DESIGNED BY: W.R. VERBOORT	REVISED:
JOB NAME: AMITY HILLS LLC	SHEET 1 OF 1