


CLAIM OF BENEFICIAL USE
 FOR BRADFORD LAVANWAY
 BY DUANE W. KIRBY
 T29S, R6W, SEC 11
 TAX LOT 300 NWNE
 APPLICATION NO S-87542
 PERMIT NO S-54646
 FISH SCREEN AT THE POD
 METER IS LOCATED UNDER HOUSE

1 INCH = 400 FEET

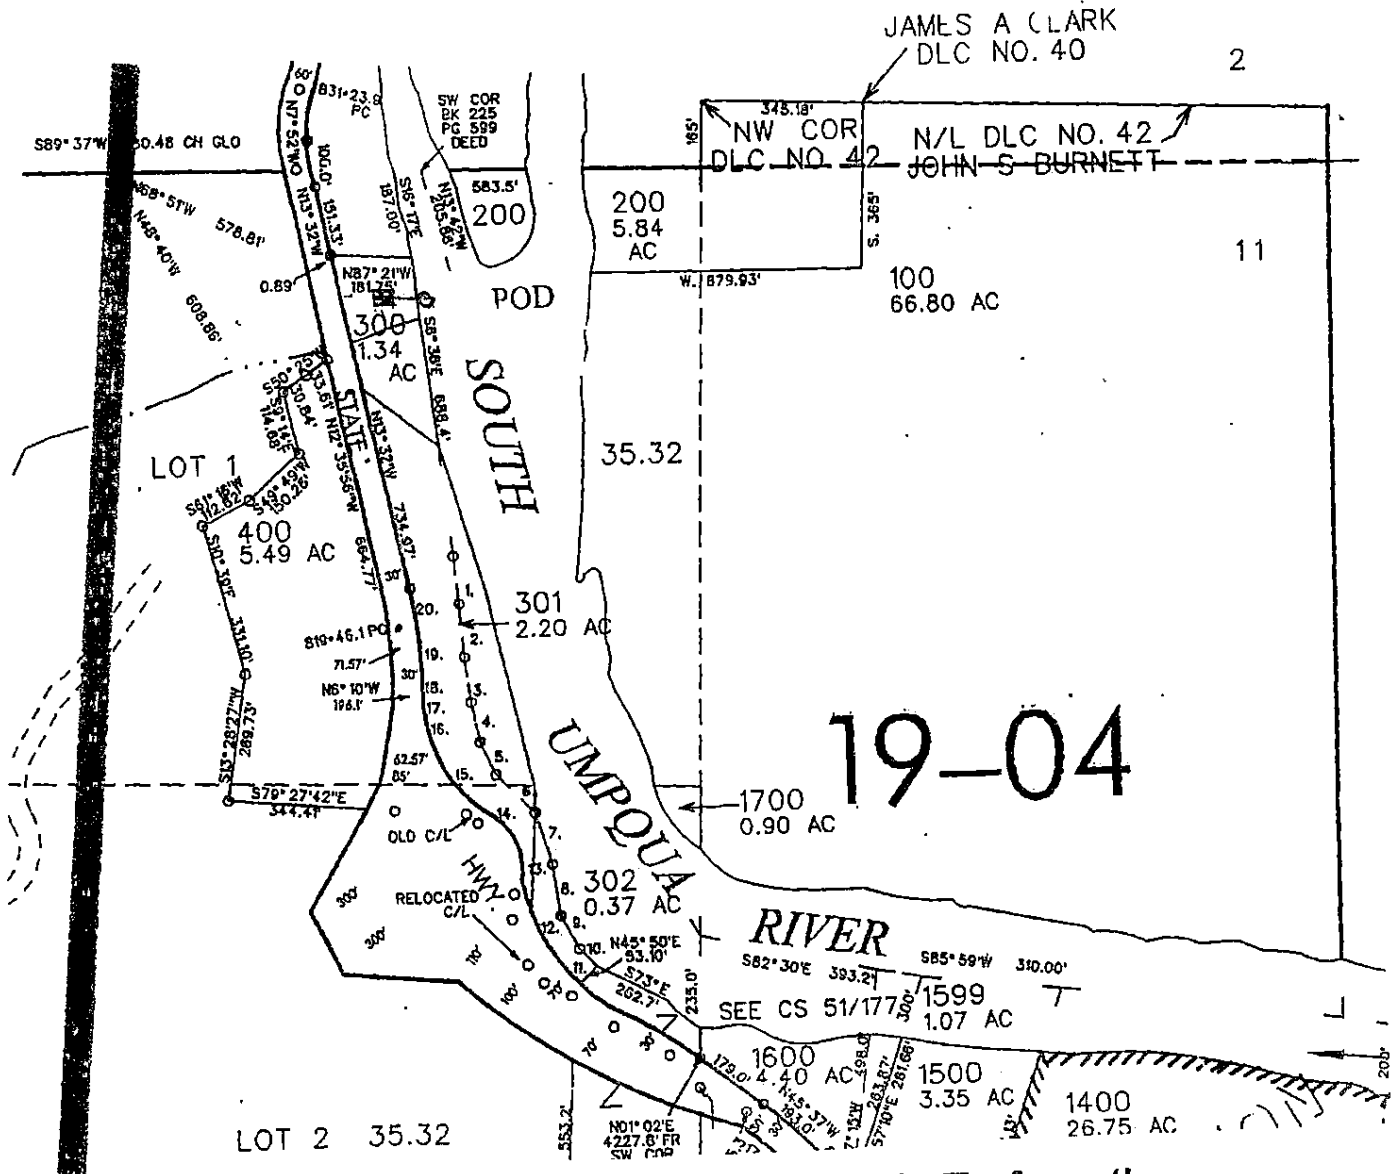

POD located 272 ft. S. and 631 ft. E. from the North Quarter Corner of Section 11.

THE PURPOSE OF THIS MAP IS TO IDENTIFY THE LOCATION OF THE WATER RIGHT. IT IS NOT INTENDED TO PROVIDE INFORMATION RELATIVE TO THE LOCATION OF PROPERTY OWNERSHIP BOUNDARY LINES.

