

RECEIVED BY OWRD


JUN 25 2015

SALEM, OR

SE $\frac{1}{2}$ , SE $\frac{1}{4}$ , SEC 19, T40S, R2E, W.M.

Lisa Buttrey and  
1211 Colestin Road  
Ashland, OR 97520-9732

TAX LOT: 4200  
**BLM LANDS**

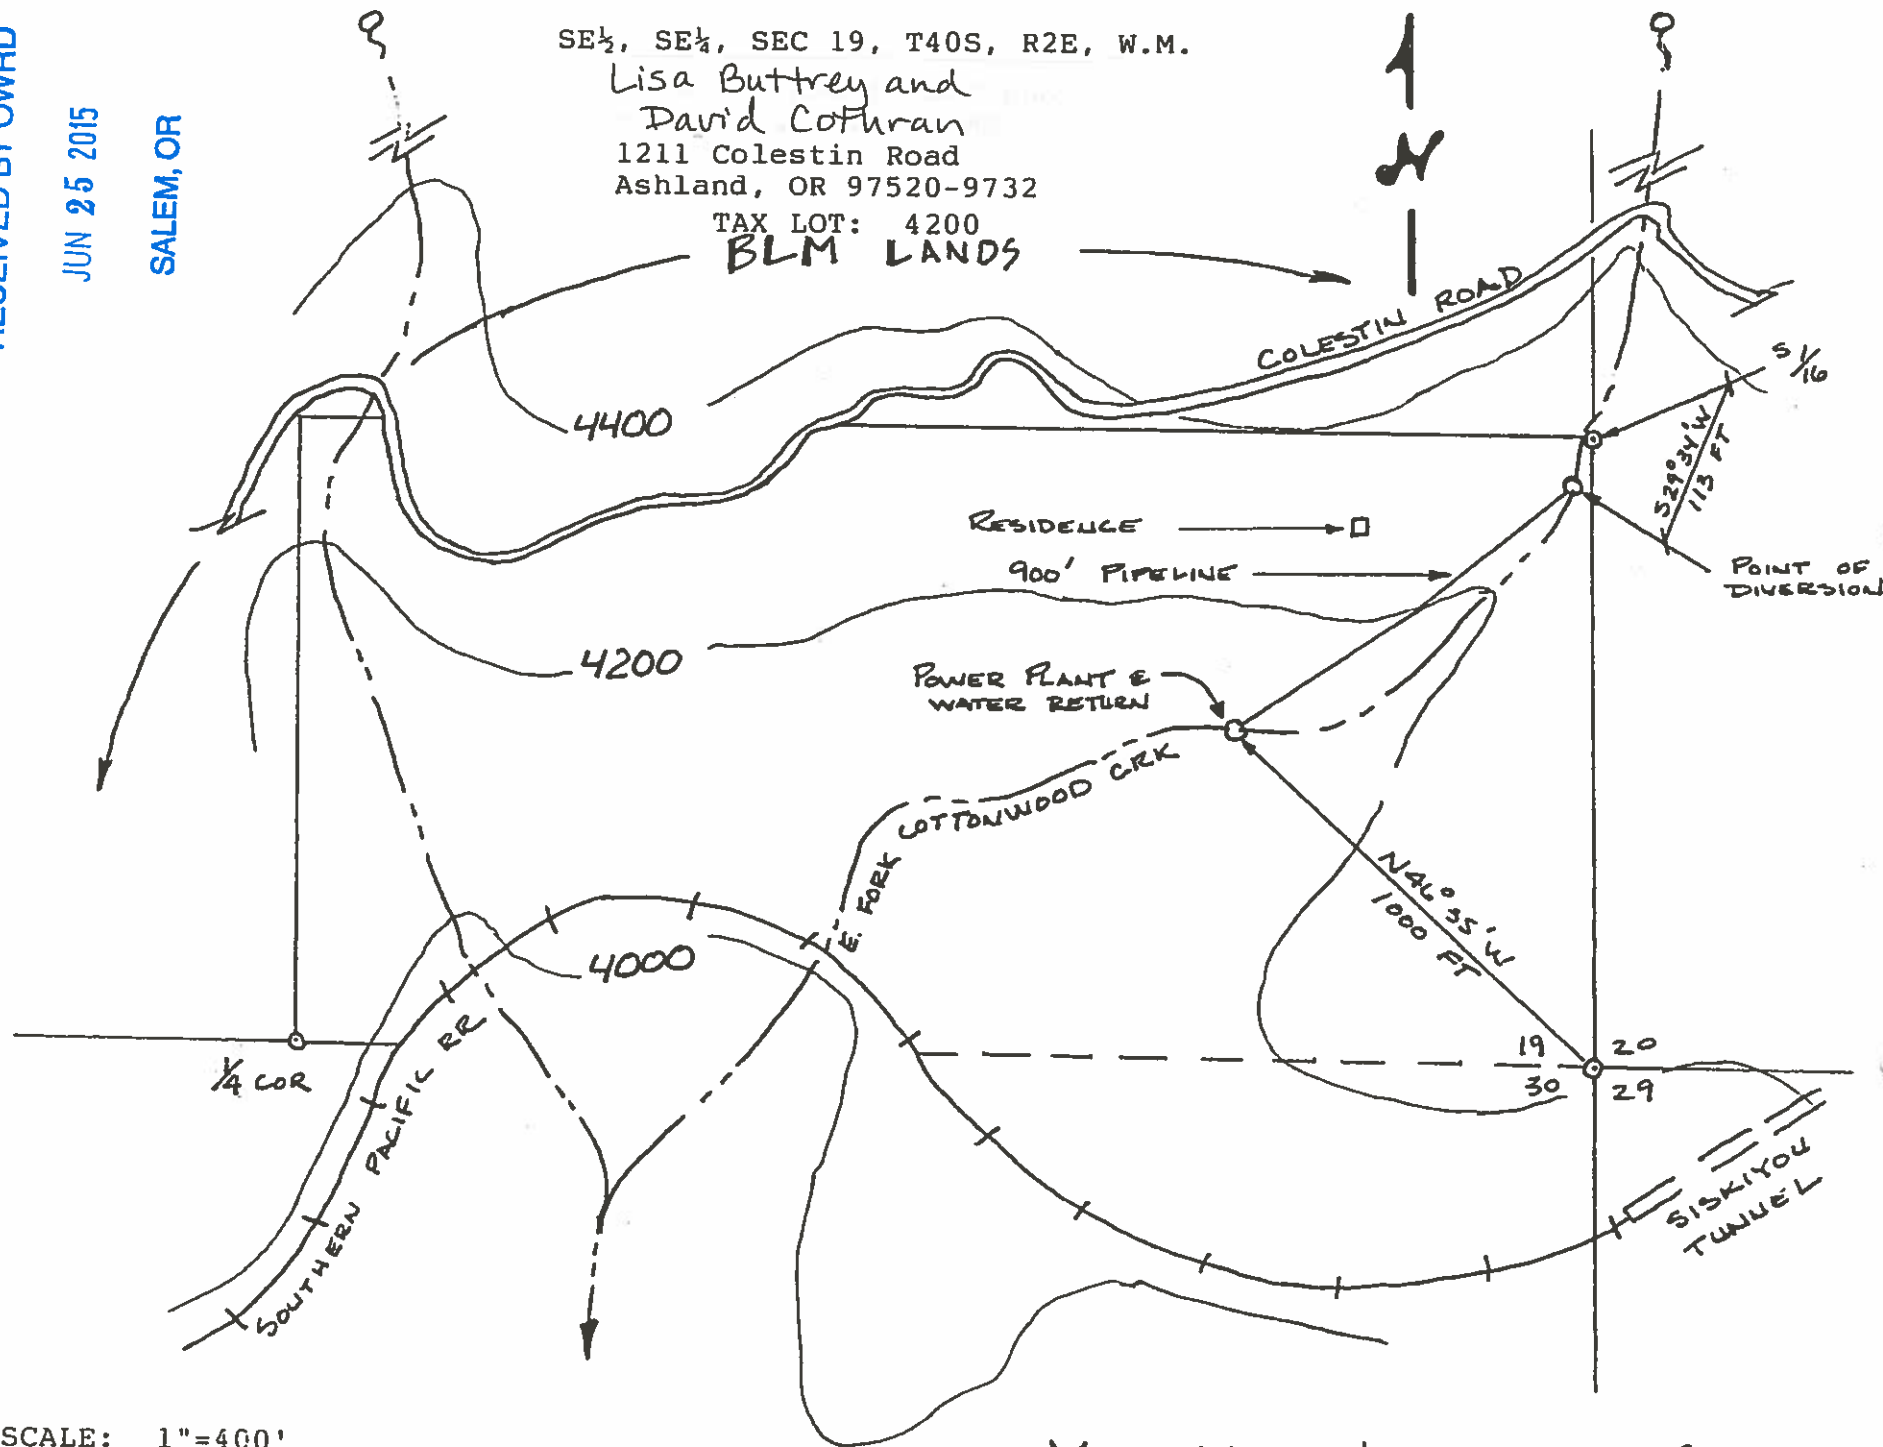

SCALE: 1"=400'

42°-04'N 122°-37'W

MAP - MINOR HYDROELECTRIC PROJECT

EXHIBIT A