



APPLICATION MAP FOR A CLAIM OF BENEFICIAL USE
 APPLICATION S-81524 PERMIT S- 53225
 IN THE NAME OF: ARTHUR A. ALLEN
 PLACE OF USE LOCATED IN THE SE 1/4, SE 1/4, SECTION 21
 TOWNSHIP 23 SOUTH, RANGE 12 WEST OF THE WILLAMETTE MERIDIAN. TAX LOT 100

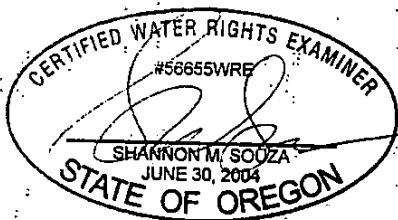

EXPIRATION DATE: 6/30/2016

LEGEND:

- FISH SCREEN and PUMP
- SUBJECT PROPERTY
- POINT OF DIVERSION
- POINT OF USE
- 1 1/4" CONVEYANCE LINE

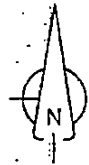

NORTH 10-MILE LAKE

POINT OF DIVERSION IS 1,332 FEET
 NORTH AND 28 FEET EAST OF THE SW
 COR. OF SECTION 21

TL2000

21 22

21 22

P.O.D.

P.O.U.

TL1200

TL100

TL200

THE PURPOSE OF THIS MAP IS TO IDENTIFY
 THE LOCATION OF THE WATER RIGHT THIS
 MAP IS NOT INTENDED TO PROVIDE LEGAL
 DIMENSIONS OR LOCATIONS OF PROPERTY
 OWNERSHIP LINES

100' 50' 0' 50' 100'
 1"=100'