


Claim of Beneficial Use, Application No. G-13126, Permit No. G-12607

This revised COBU map is based on J. Edward Henricks COBU "Final Proof Survey" map received Aug. 1, 2000 by OWRD. Revises the 4.0 ac. shown in NESW to 3.5 ac. in NESW (Lot 3A) and 28.0 ac. in SESW to 28.5 ac. in SESW (Lot 4A).

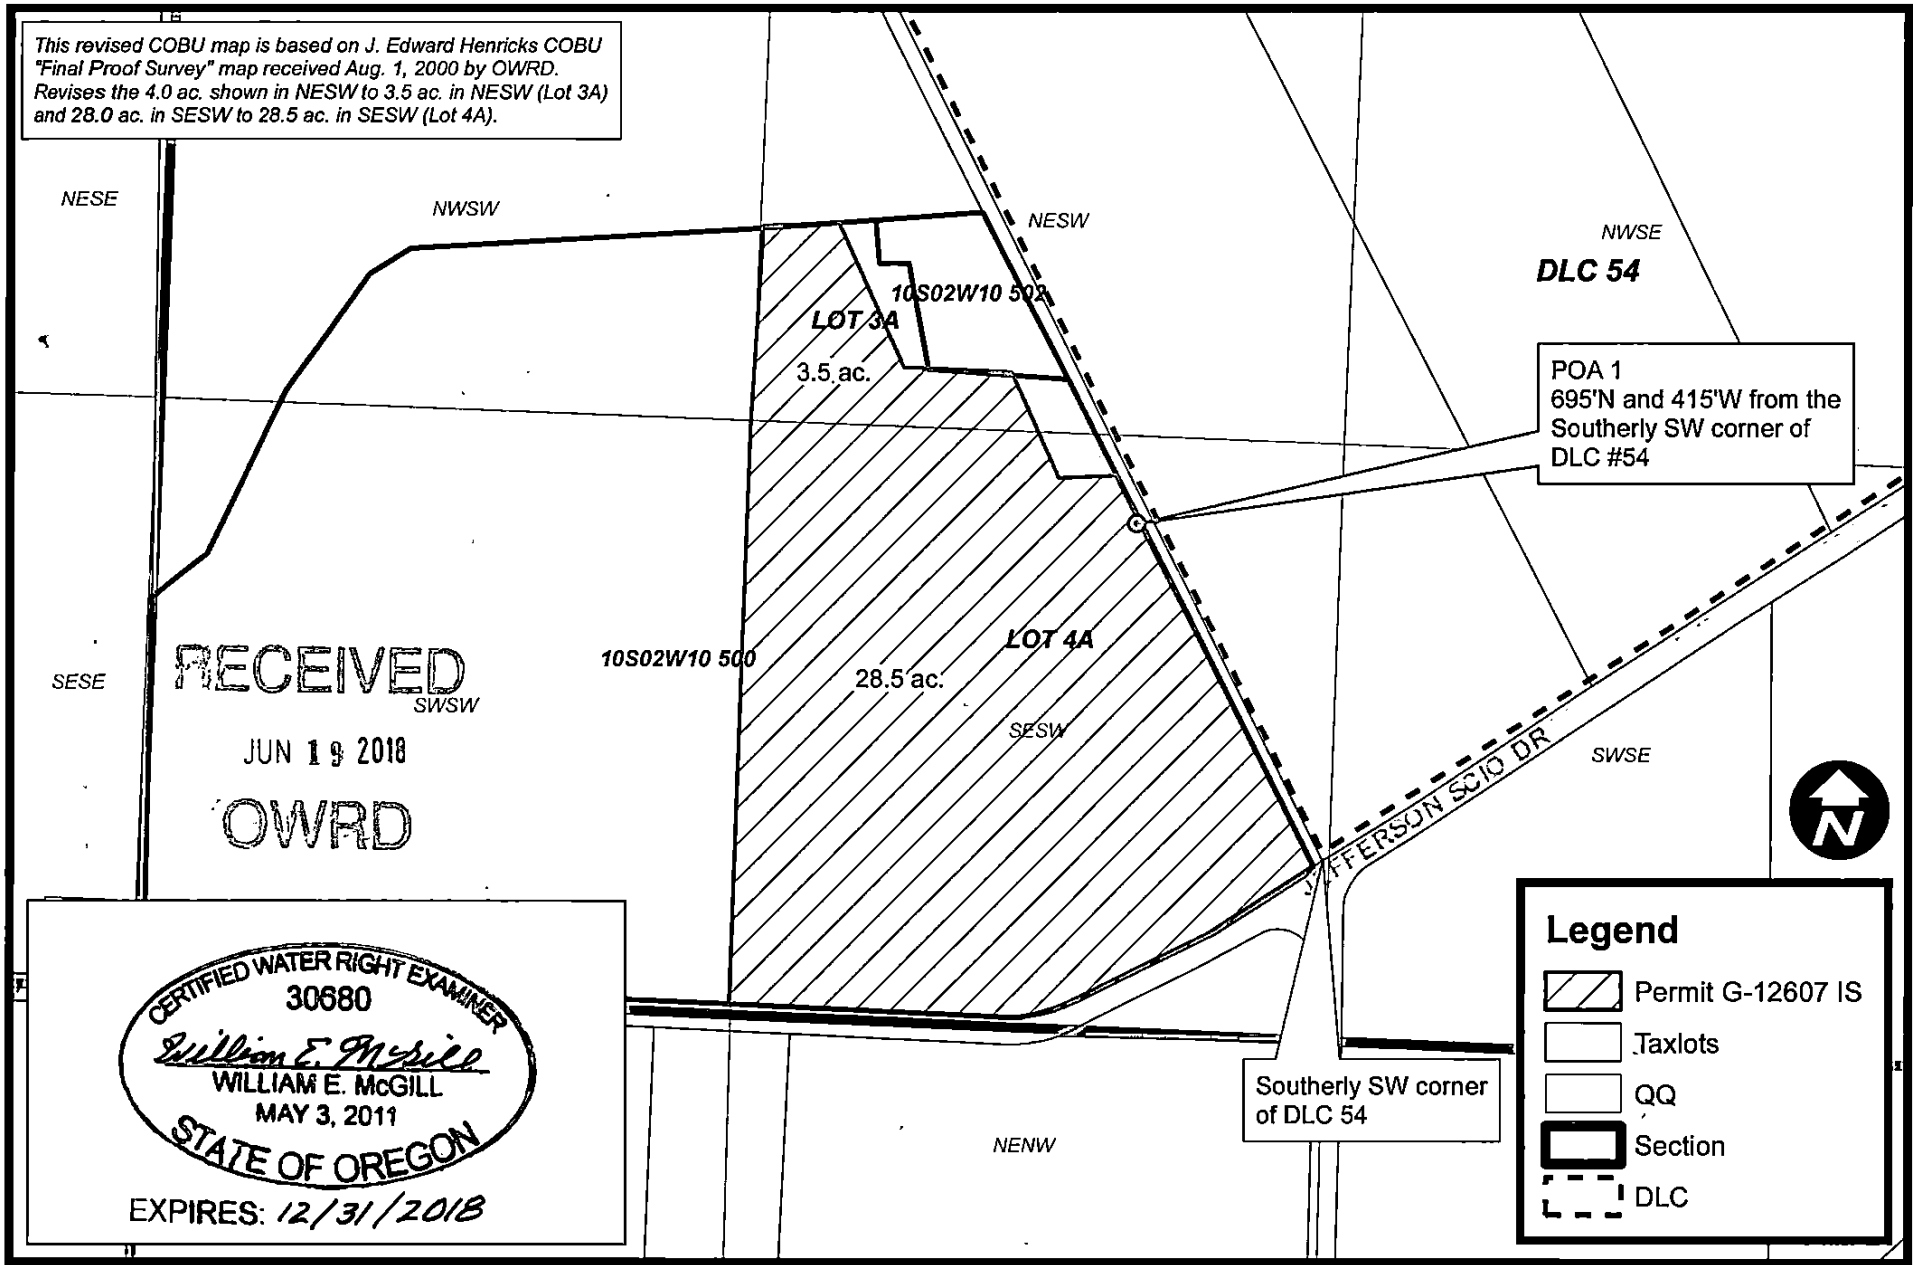

This map is not intended to provide legal dimensions or locations of property ownership lines.

