

RECEIVED

MAR 1 2018

OWRD

Claim of Beneficial Use Map

Transfer T-11887

Township 16 South, Range 4 West (W.M.)



Document Path: \\work\landrights\egreen\116\11887\11887_Support\Project_GIS\Project_mxd\11887.mxd


LEGEND

- Point of Appropriation (POA)
- Place of Use (POU) - Per Transfer Final Order
- Donation Land Claim (DLC)
- Watercourse
- Waterbody

POA LOCATION DESCRIPTION

Well 3
 Located 1,389 feet South and 1,269 feet East from the NW corner of DLC 39, Township 16 South, Range 4 West (W.M.)

Certified Water Rights Examiner Stamp

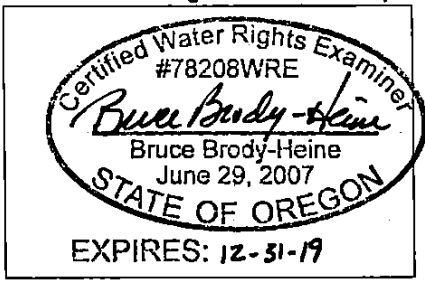

DISCLAIMER

This map was prepared for the purpose of identifying the location of a water right only and it is not intended to provide legal dimensions or location of property ownership lines.

MAP NOTES

Date: February 1, 2018
 Data Sources: OGIC, ESRI, Lane Co., USGS

