

DOUGLAS STREET

CLAIRMONT STREET

SECOND STREET

SPRUCE STREET

FIRST STREET (HWY 82)

TENNIS COURT

3.0 AC IN NE 1/4, NW 1/4

TL 5400 IN 42 14AB

TL 10200 IN 42 14AB

0.5 AC IN NW 1/4, NE 1/4

BLDG'S & GROUNDS

WELL LOCATION

7'

2'


1/16 COR (SW CORNER OF NW 1/4, NE 1/4, SEC 14, T 1N, R 42E)



1" = 100'  
IN SEC 14, T 1N, R 42E, WM.

THIS MAP IS BASED ON WALLOWA CO. ASSESSOR MAPS IN 42 14 BA & AB.  
THIS MAP IS PREPARED FOR WATER RIGHT PURPOSES ONLY AND SHOULD NOT BE USED FOR PROPERTY LOCATION PURPOSES.

WELL LOCATION IS 410' WEST AND 125' NORTH OF THE SW COR. OF NW 1/4, NE 1/4 SEC 14  
FINAL PROOF SURVEY IS FOR THE AREAS SHOWN HATCHED AND WHICH ARE PRESENTLY IN GRASS.

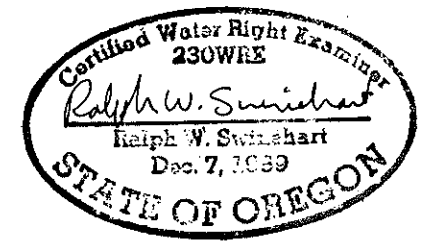

RECEIVED

SEP - 2 1997  
WATER RESOURCES DEPT.  
SALEM, OREGON

FINAL PROOF SURVEY MAP  
PERMIT: G-12645  
FOR: WALLOWA SCHOOL DIST. #12

DATE 8/11/97	WALLOWA MOUNTAIN ENGINEERING PO BOX 288 ENTERPRISE, OREGON 97828 426-4085	REVISIONS	SHEET
JOB 95703			1
DESIGN RWS			OF
DRAWN TCB			

P10431