


11-27-1973

V23, P45

JOHN LOUISIGNOUT D.L.C. 52

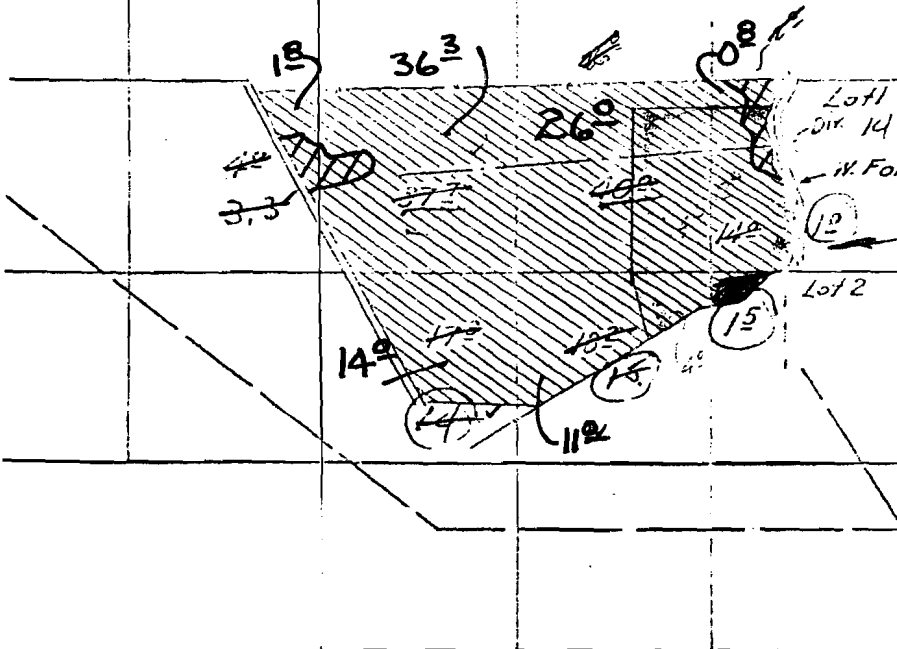

Lot 1
Dix 14

W. Fork Dairy Cr.

AREA IN BLUE IS AN ACCURATE
 REPRESENTATION OF THE ACRES
 LISTED ON THE TRANSFER
 1-11-80

14

13

RECEIVED

FEB 28 2005
 WATER RESOURCES DEPT.
 SALEM, OREGON

Approved Aug 15, 1941
John Louisignout

Acres 17702

Per. 13303

