



OVERVIEW MAP

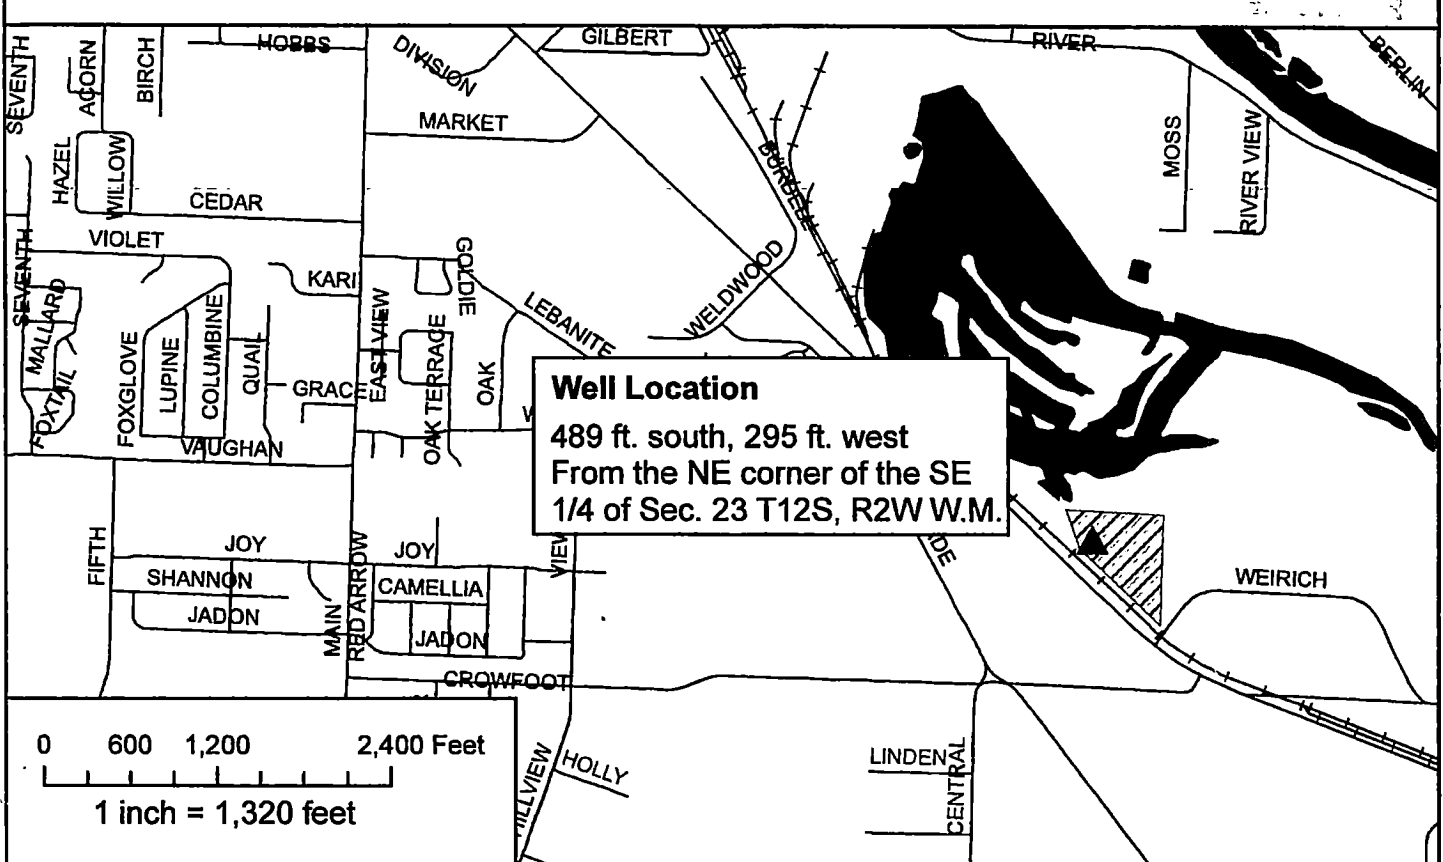

DETAIL MAP -- New Well Location

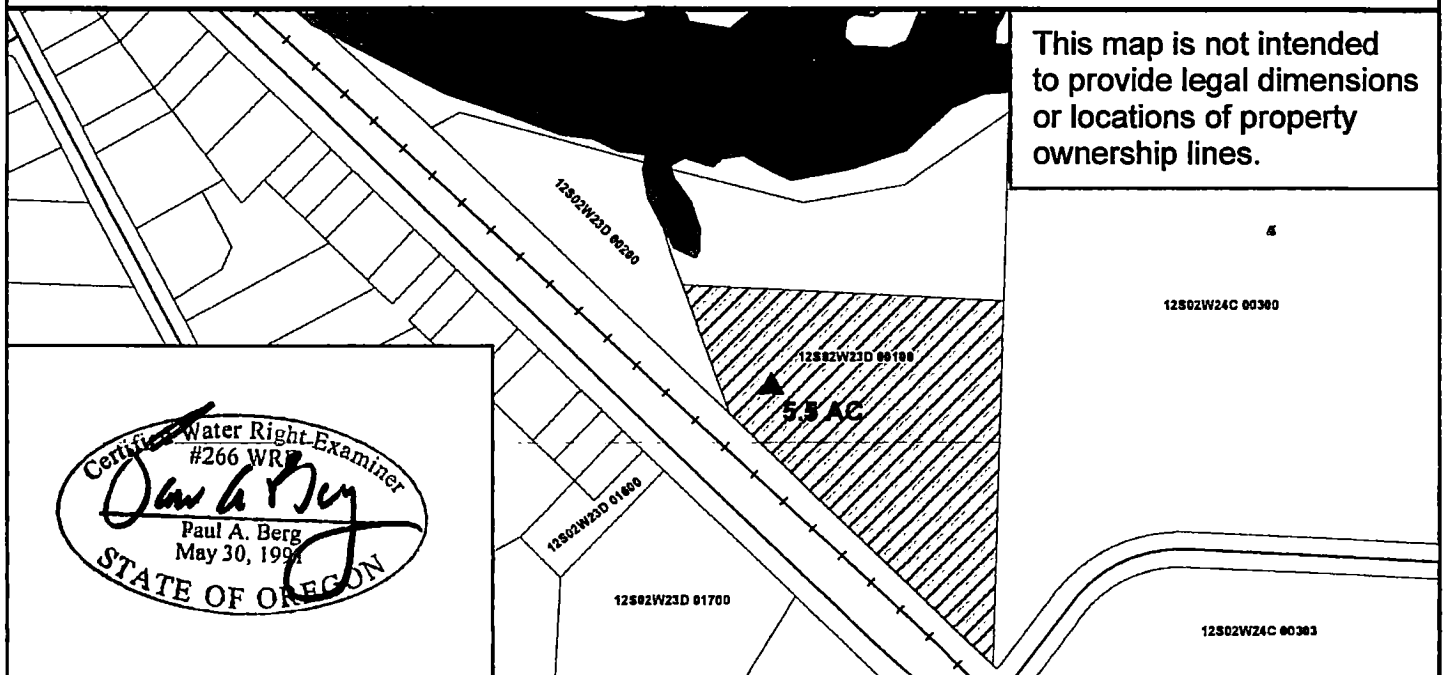

12S02W23D
LEBANON

Cancelled Nos
2302
8701
8702
8201
10200
8500

12S02W23D
LEBANON
5/22/2015