

CLAIM OF BENEFICIAL USE MAP

LOCATED IN THE NW 1/4 NW 1/4 OF SECTION 9,
TOWNSHIP 23 SOUTH, RANGE 12 WEST, W.M., COOS COUNTY, OREGON
APPLICATION S-86720, PERMIT S-54515

SECTION 4
SECTION 9

SURVEY METHOD:

THE POINT OF DIVERSION WAS TIED BY TOTAL STATION TRAVERSE TO SEVERAL LOT CORNERS WITHIN THE PLAT OF NORTH LAKE ESTATES NO.1. THE LOCATION OF THE WEST 1/16 CORNER WAS CALCULATED FROM THESE MONUMENTS BASED ON RECORD DIMENSIONS SHOWN PER SAID PLAT.

POINT OF DIVERSION LOCATION:

THE POINT OF DIVERSION LIES SOUTH 617 FEET AND WEST 157 FEET FROM THE WEST 1/16 CORNER COMMON TO SECTION 4 AND SECTION 9.


EXAMINER'S DISCLAIMER STATEMENT

THE PREPARATION OF THIS MAP WAS FOR THE PURPOSE OF IDENTIFYING THE LOCATION OF THE WATER RIGHT ONLY AND HAS NO INTENT TO PROVIDE DIMENSIONS OR LOCATION OF PROPERTY OWNERSHIP LINES.



RECEIVED
JUL 02 2018
OWRD

SCALE
1" = 100 FT.

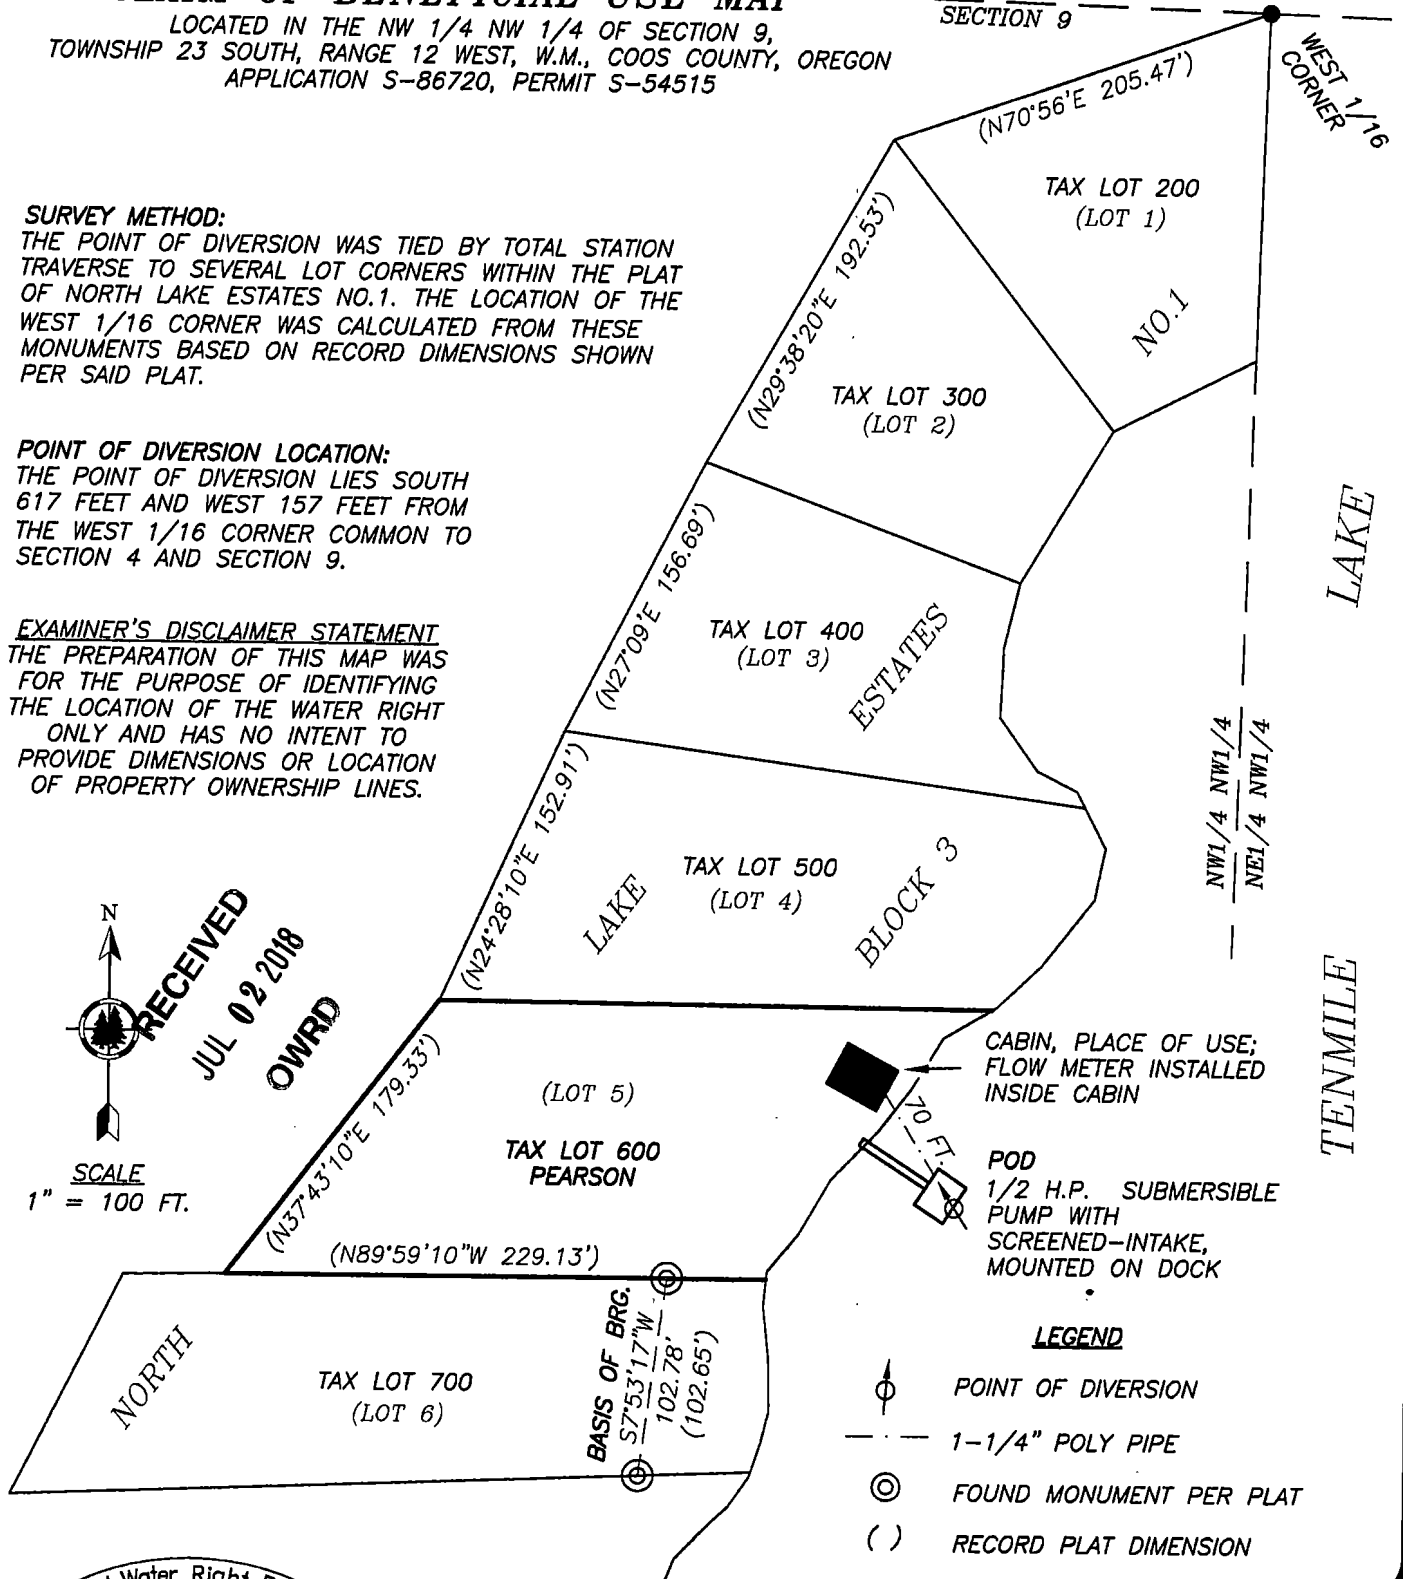

Stuntzner

Engineering
& Forestry, LLC

705 S. 4TH ST.
P.O. BOX 118
COOS BAY, OREGON 97420

PHONE: (541) 267-2872
FAX: (541) 267-0588
www.stuntzner.com

Engineering - Land Surveying - Forestry - Land Planning - Water Rights

JOB #: 114-056

DATE: August 2014

DRAWN BY: CMW

CHECKED BY: CMW

PREPARED

FOR:

Emily Pearson
Idyllwild, CA

FILE NAME: 114-056 COBU_2018.dwg

SHEET 1 OF 1