

LEGEND | DISCRIPTION | SYMBOLS | |-------------|---------| |-------------|---------|

SECTION LINE	—————
QUARTER-QUARTER LINE	- - - - -
TAX LOT LINE	=====
CREEK	~~~~~
CANAL	=====
SECTION CORNER	30 31 1 6
PUMP	⊕


Certificates:

Certificate 8377 (1886)	
Certificate 8377 (1888)	
Certificate 28157	
Certificate 44856	


POINTS OF DIVERSION LOCATIONS

Authorized POD: N25°E AND 2700' FROM THE N 1/4 CORNER SECTION 28, T28S., R.48 E., W.M.

Current POD 2795' NORTH AND 9220' EAST OF THE NE CORNER SECTION 28, T28S., R.48 E., W.M.

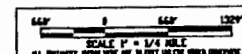


T 12423

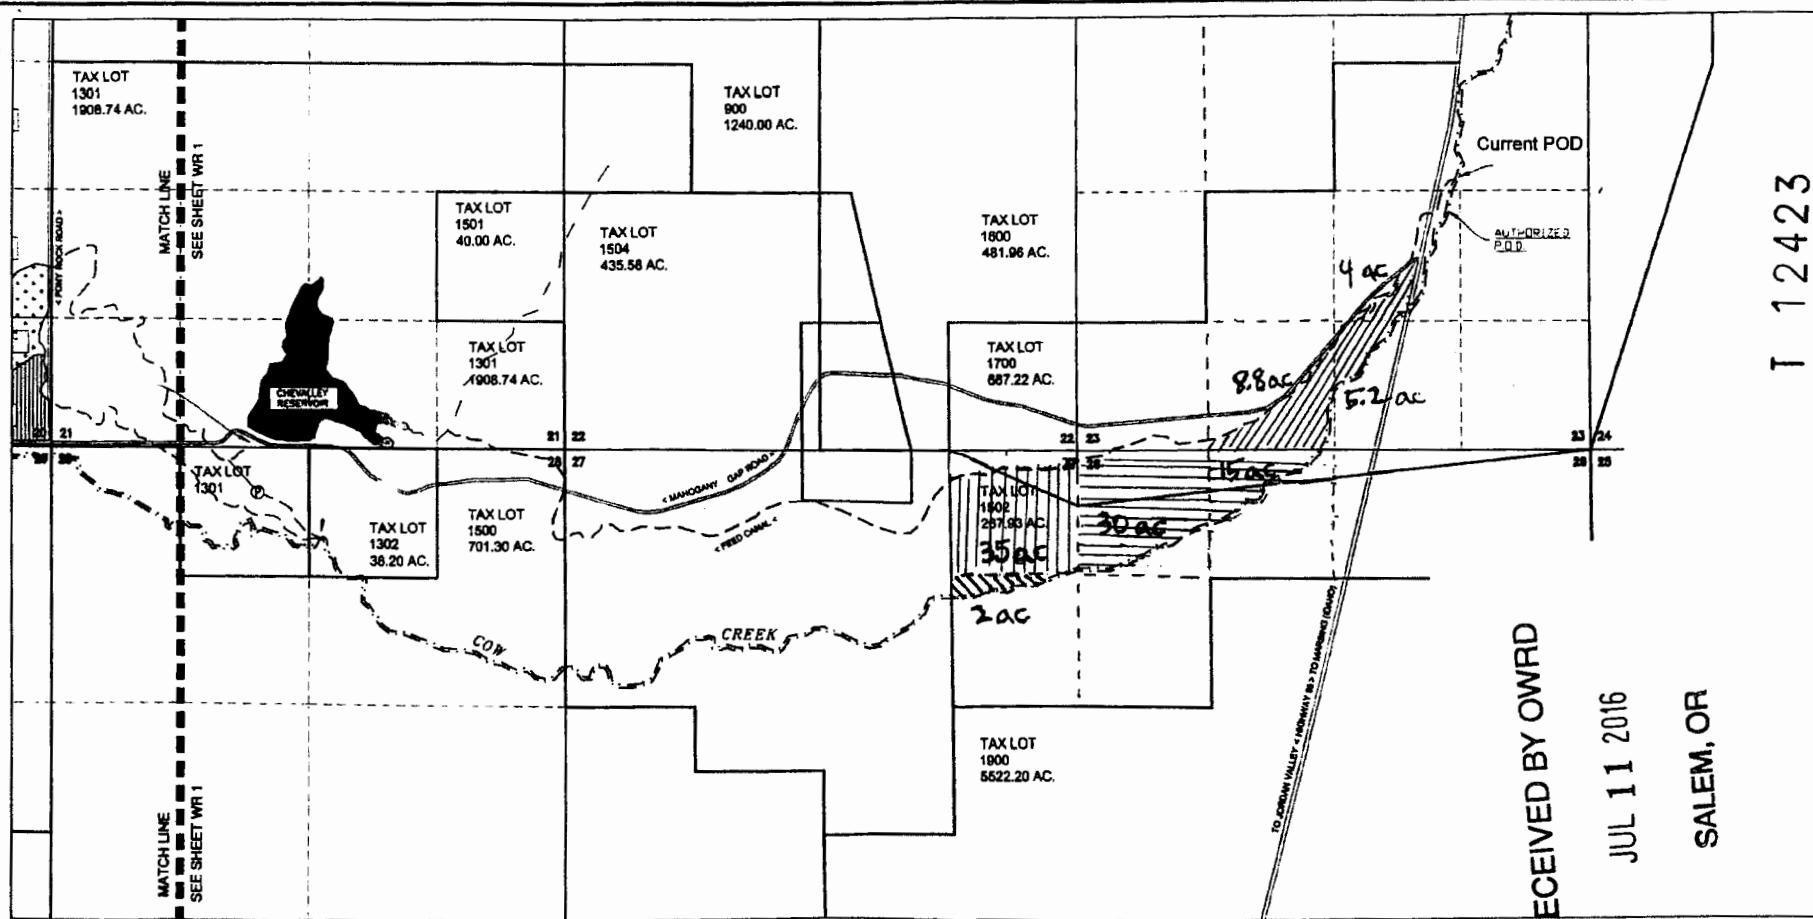

RECEIVED BY OWRD
JUL 11 2016
SALEM, OR

Township 28 S , Range 46 E .

22-2-4

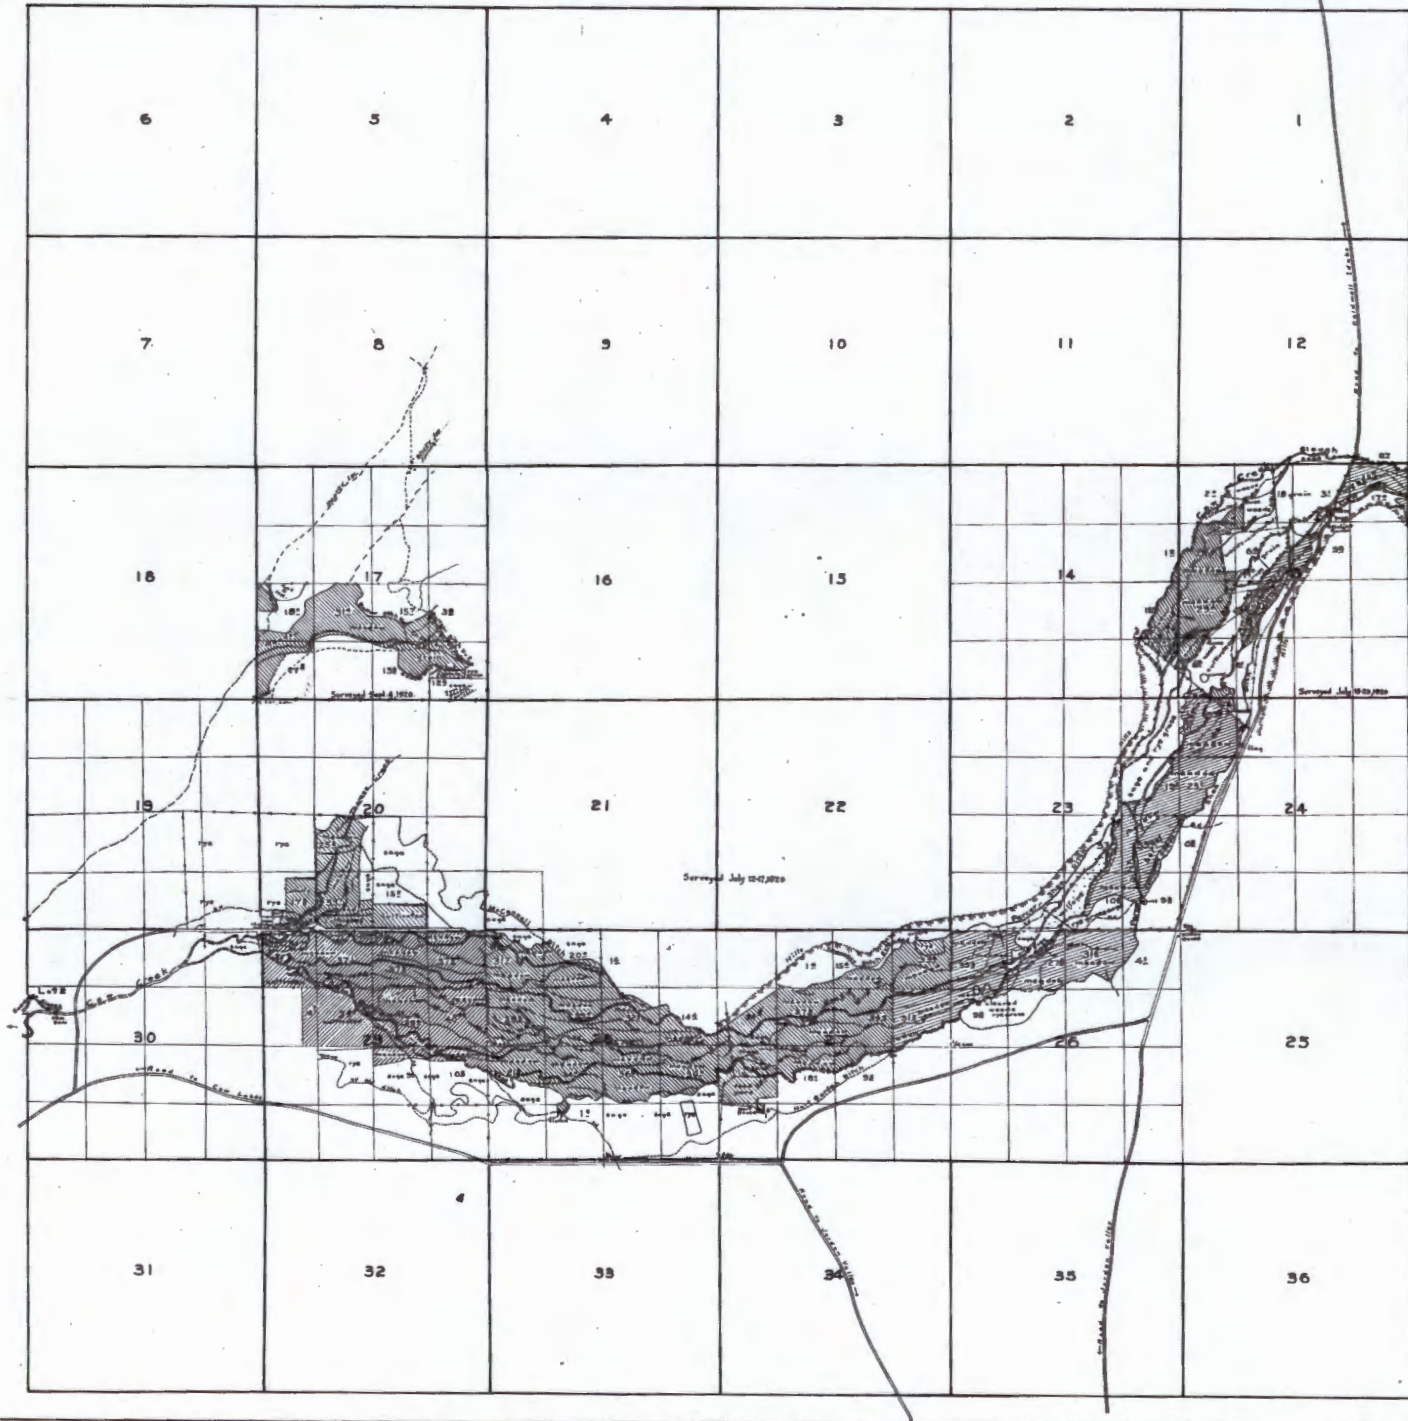

RECEIVED BY OMRD

JUL 11 2016


SALEM, OR

T 12423

JUL 11 2016

SALEM, OR

22
T 12423

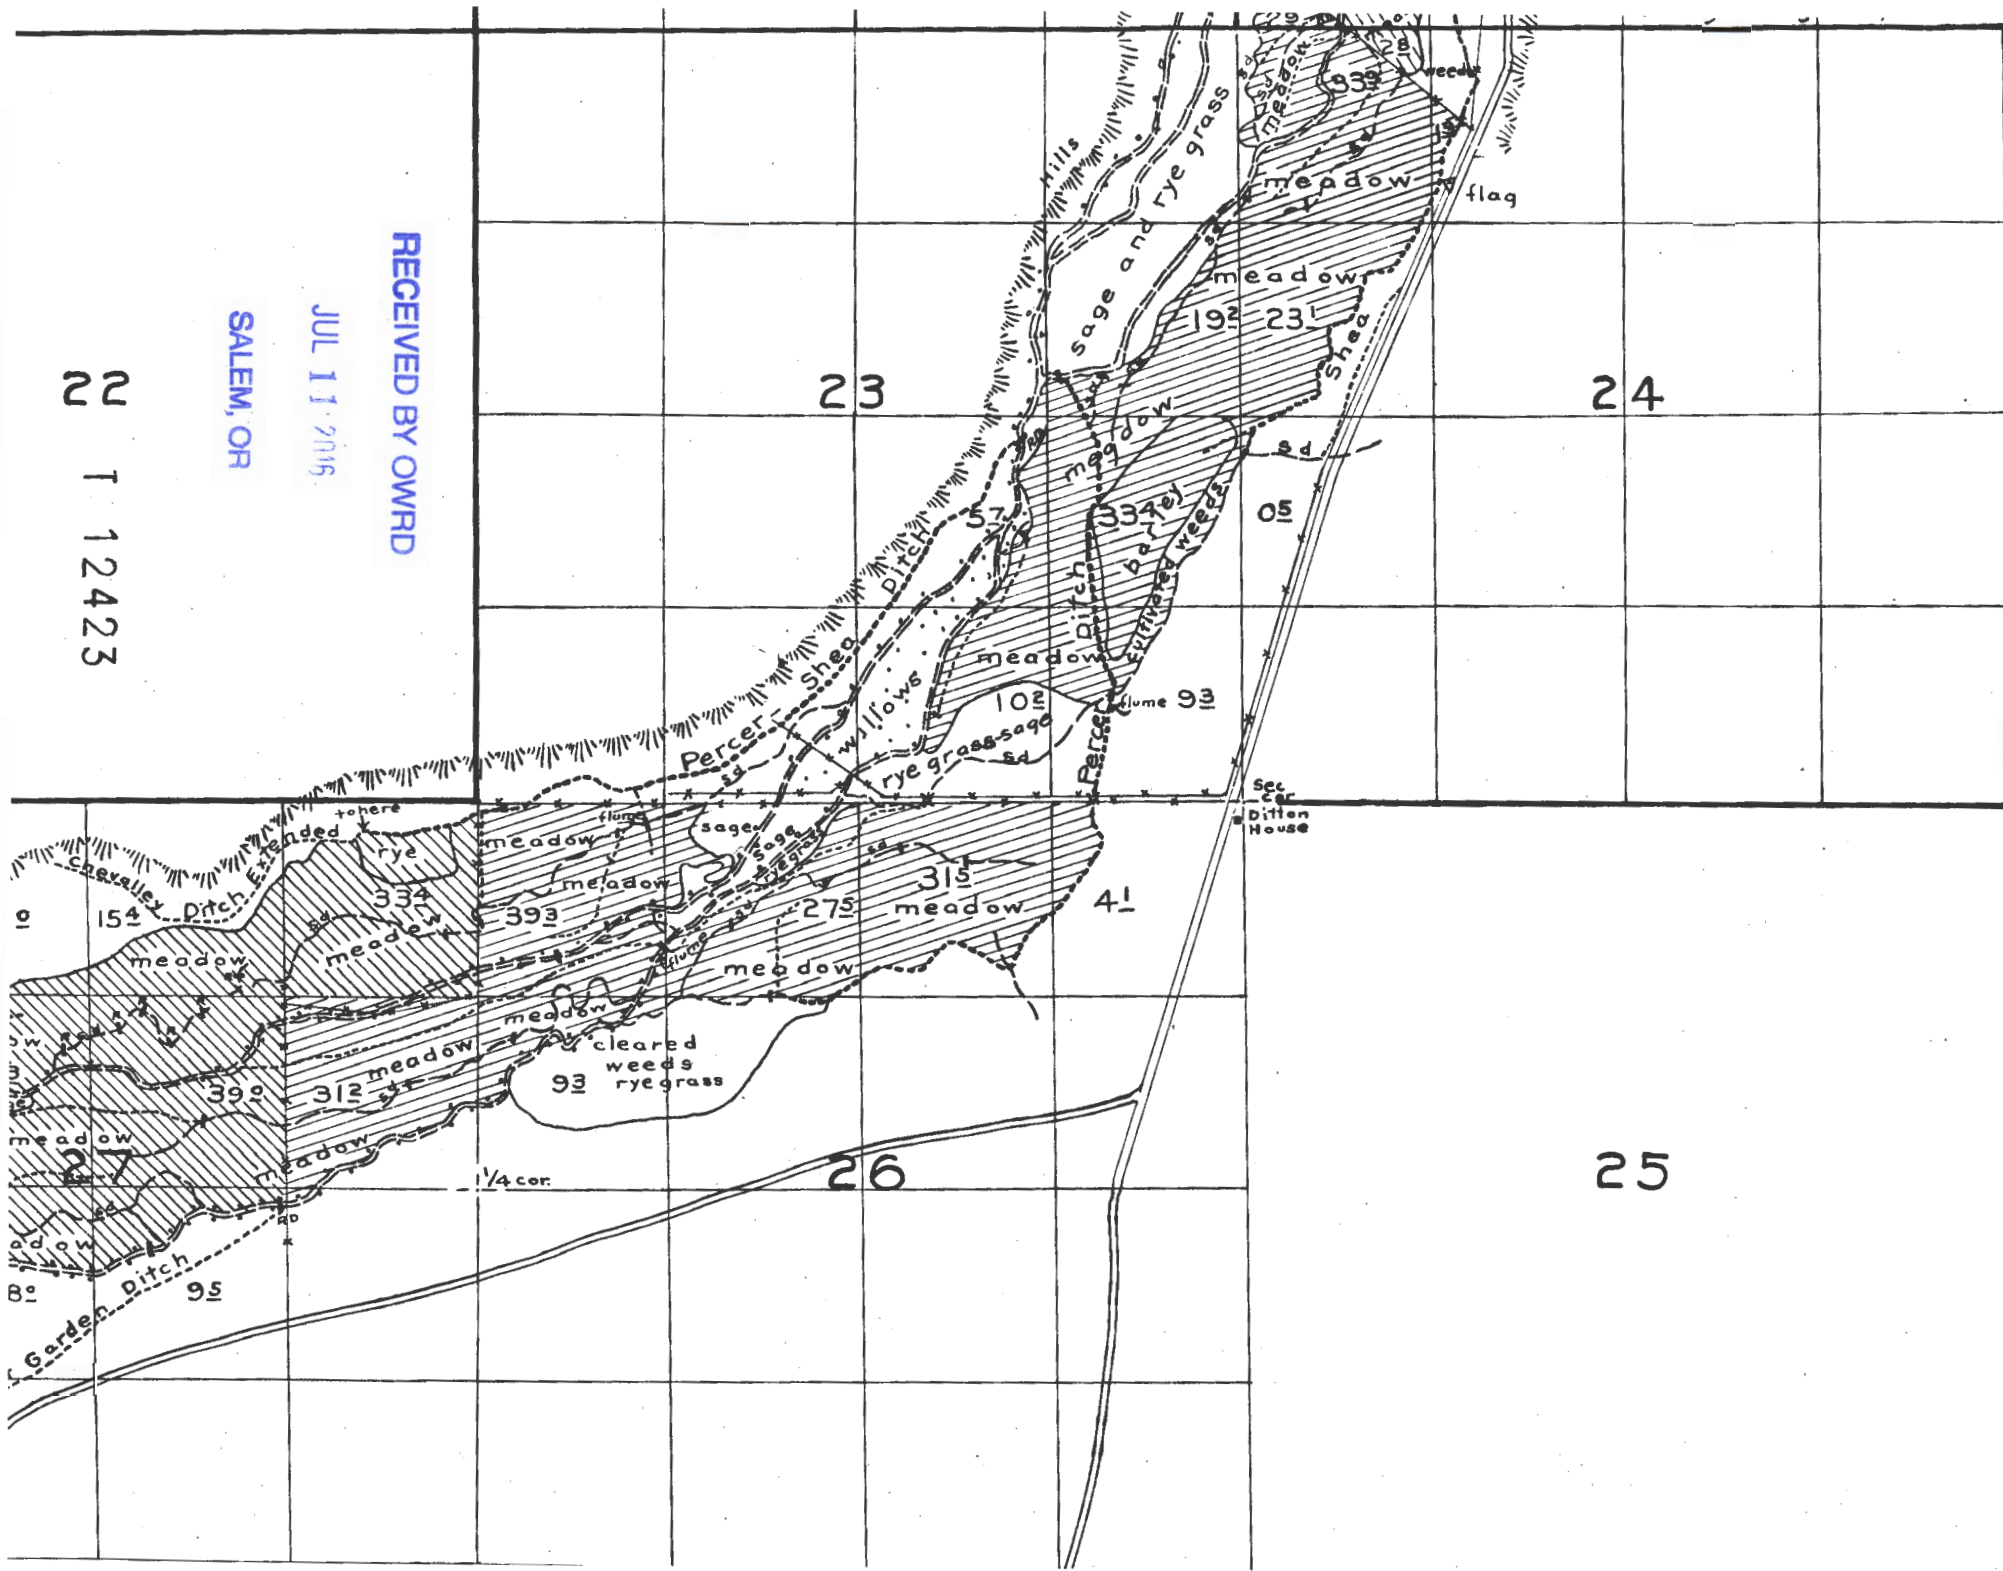

WC BRIDE, TIMOTHY S

LR RANCH, LLC

BALTZOR CATTLE CO.

BALTZOR CATTLE CO

BALTZOR CATTLE CO INC

BALTZOR CATTLE CO INC

BALTZOR CATTLE CO.

LR RANCH, LLC

USA

SALEM, OR

RECEIVED BY OWRD
28
NEBW
61

T 12423