


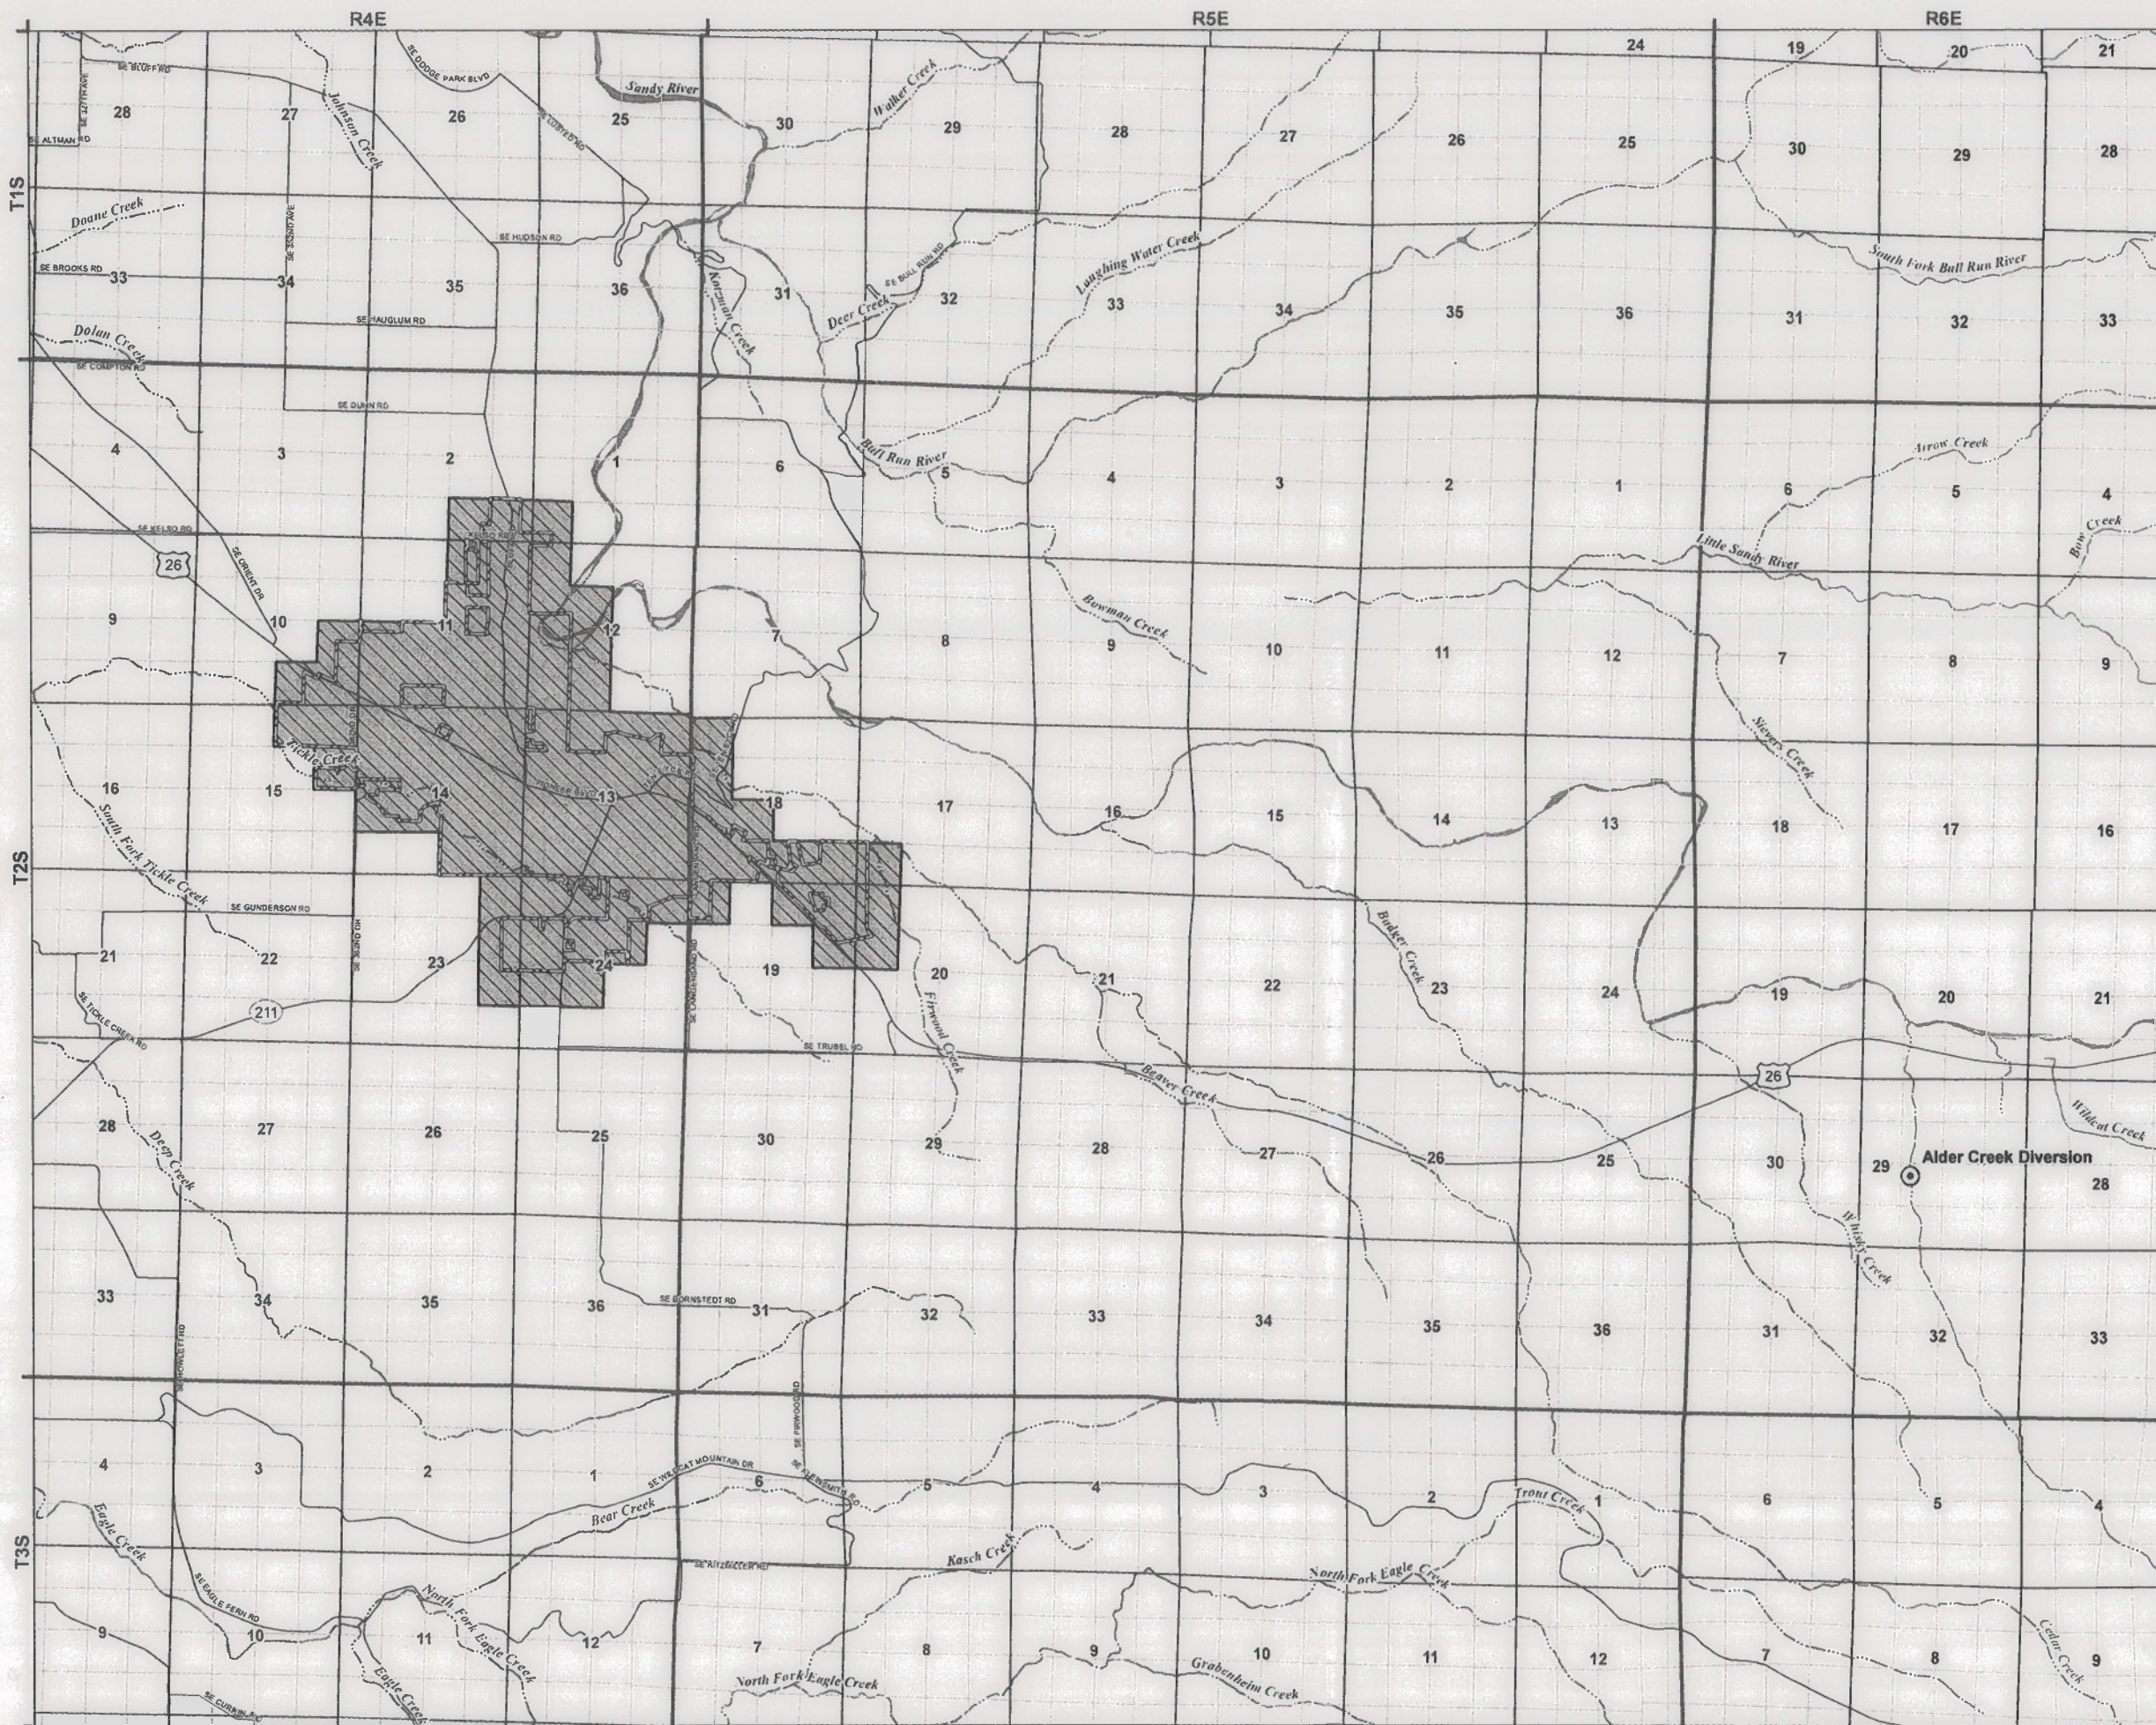

Claim of Beneficial Use in the Name of the City of Sandy


Place of Use Map

Permit S-36601, Application S-48840
Clackamas County, Oregon

LEGEND

- Point of Diversion (POD)
- Place of Use (POU)
- Sandy City Limits (Service Area)
- Major Roads
- Watercourses
- Waterbodies

Certified Water Rights Examiner Stamp

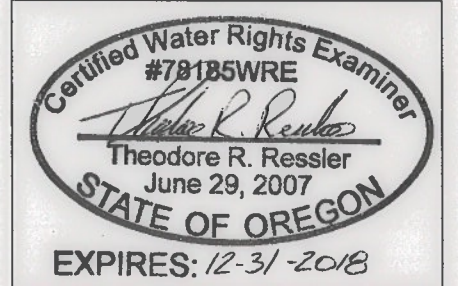

RECEIVED

FEB 23 2018

OWRD

DISCLAIMER

This map was prepared for the purpose of identifying the location of a water right only and it is not intended to provide legal dimensions or location of property ownership lines.



0 0.5 1 1.5
1 inch = 1 mile


MAP NOTES:

Date: July 15, 2015
Data Sources: OWRD, Metro RLIS, USGS



Claim of Beneficial Use in the Name of the City of Sandy Point of Diversion Map

Permit S-36601, Application S-48840
Clackamas County, Oregon
Township 2 South, Range 6 East (W.M.)

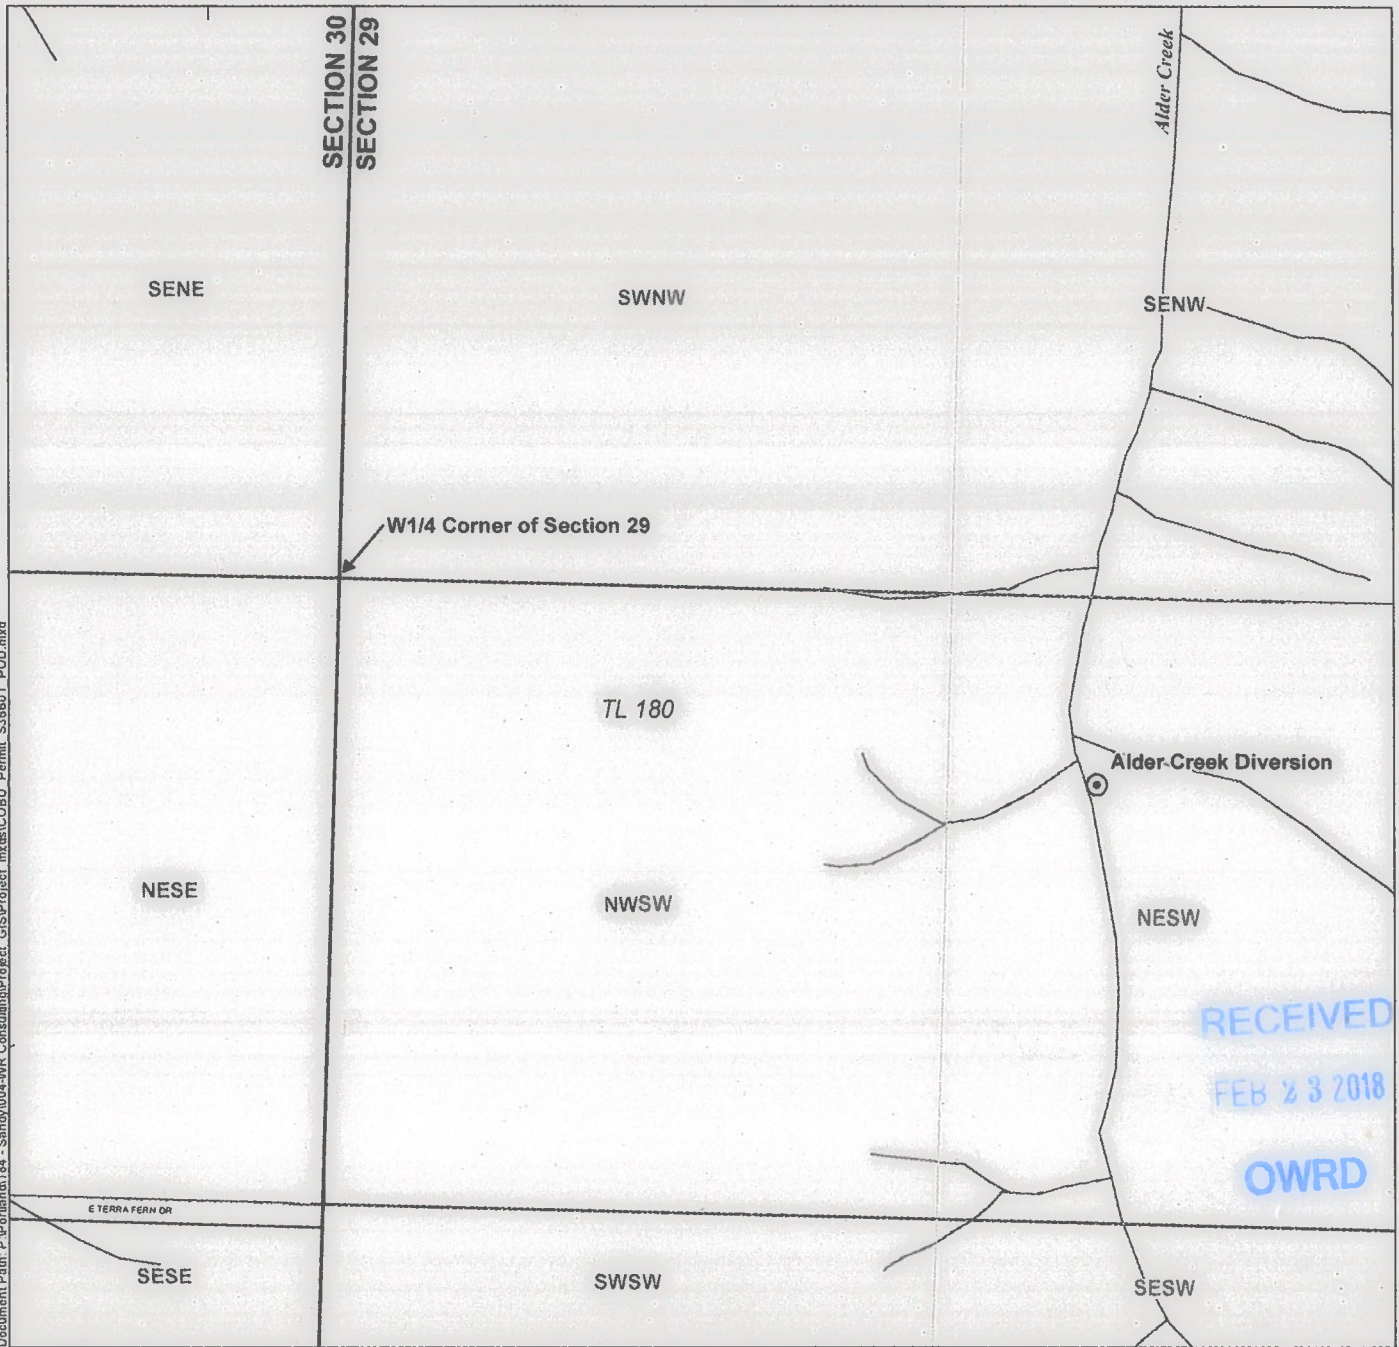


LEGEND

- Point of Diversion (POD)
- Tax Lot
- Watercourse

POD LOCATION DESCRIPTION

Alder Creek Diversion
1,595 feet East and 385 feet South from the W1/4 corner of
Section 29, Township 2 South, Range 6 East (W.M.)

Certified Water Rights Examiner Stamp

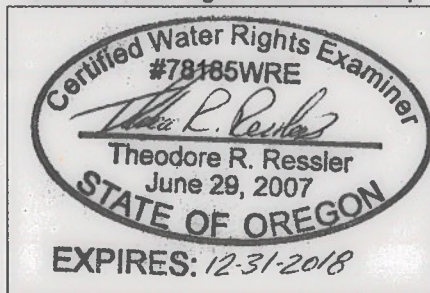

DISCLAIMER

This map was prepared for the purpose of identifying the location of a water right only and it is not intended to provide legal dimensions or location of property ownership lines.

MAP NOTES

Date: February 16, 2018
Data Sources: OWRD, Metro RLIS, USGS

