
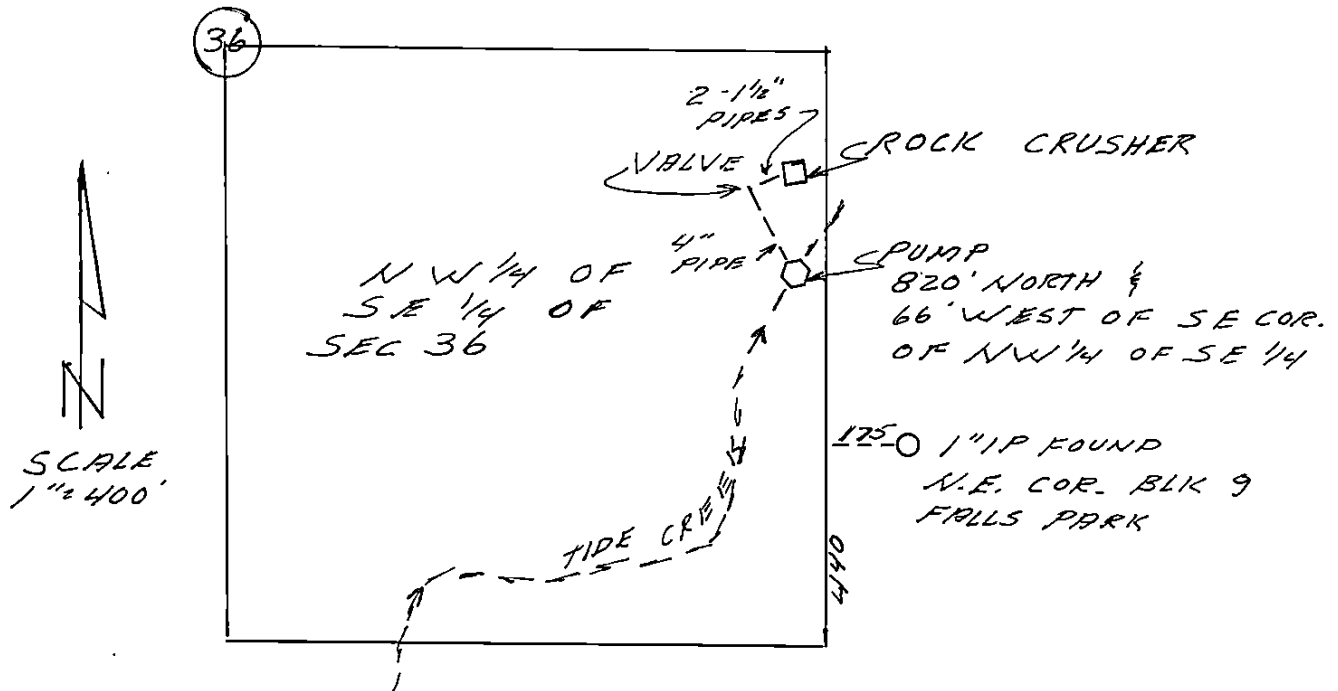


RECEIVED

JUN 10 1992

WATER RESOURCES DEPT.
SALEM, OREGON

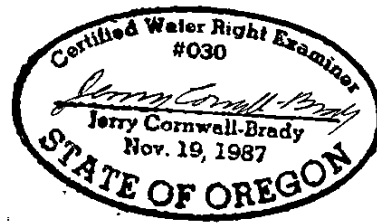

FINAL PROOF SURVEY

PERMIT No. 51024

IN THE NAME OF

JOHN A. PETERSEN - TIDE CREEK ROCK
SECTION 36 T6N R2W

COLUMBIA CO. ORE

JUNE 5 1992