T. 6S. R1W., W.M.

Roth Family, LLC
SECTIONS 27 AND 28
MARION COUNTY
12513 HOBART ROAD
SILVERTON, OR 97381

Certified Water Right Examiner
#372 WRE
John E. Borden
May 11, 1994
STATE OF OREGON
Exp: 12-31-245

LEGEND
- P.O.U. - PRIMARY
- USGS GRID
- DLC LINE
- TAXLOT LINE
- ROADWAY
- STRUCTURE
- WELL
- SECTION CORNER
- DLC CORNER

SCALE: 1" = 800'

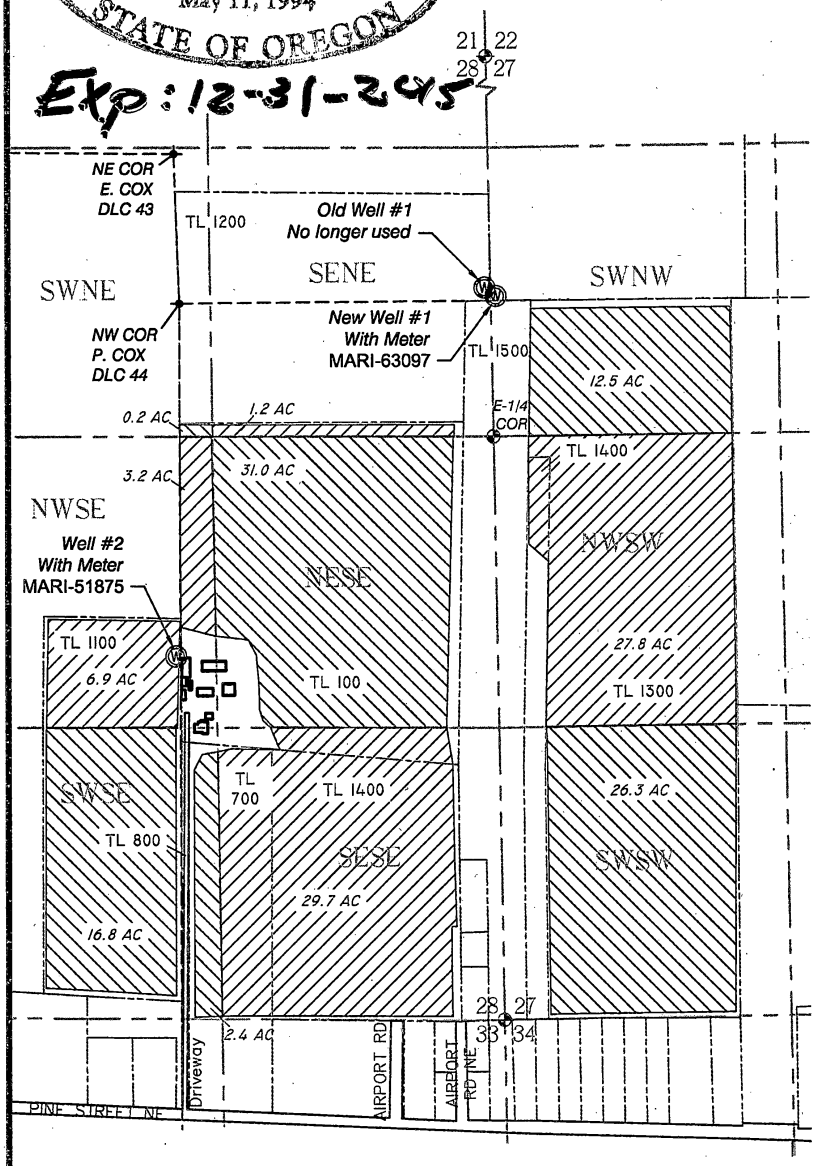

PREPARATION OF THIS MAP IS FOR THE PURPOSE OF IDENTIFYING THE LOCATION OF THE WATER RIGHT ONLY. THERE IS NO INTENT TO PROVIDE DIMENSIONS OR LOCATION OF PROPERTY OWNERSHIP LINES.

P.O.U. - PLACE OF IRRIGATION USE

SECTION	1/4-1/4	DLC	PRIMARY ACRES	SUPPLEMENTAL ACRES
27	SWNW	44	12.5	12.5
27	NWSW	44	27.8	27.8
27	SWSW	44	26.3	26.3
SEC 27 TOTAL			66.6	66.6
28	SWNE	44	0.2	0.2
28	SENE	44	1.2	1.2
28	NESE	44	31.0	31.0
28	NWSE	44	3.2	3.2
28	NWSE	43	6.9	6.9
28	SWSE	43	16.8	16.8
28	SWSE	44	2.4	2.4
28	SESE	44	29.7	29.7
SEC 28 TOTAL			91.4	91.4
TOTAL P.O.U. ACRES			158.0	158.0

RECEIVED
JAN 29 2015
WATER RESOURCES DEPT.
SALEM, OREGON

CLAIM OF BENEFICIAL USE

SUPPLEMENTAL IRRIGATION
TRANSFER T-11594
In The Name of Roth Family, LLC
to make up a Deficiency in Rate
for Permit G-11434 of 158.0 Acres
from Two (2) Wells in the Willamette River Basin
Surveyed December 5, 2013, by John E. Borden, CWRE

NOTES:

OLD WELL #1 IS 1975 FEET SOUTH AND 25 FEET WEST FROM THE NE COR OF SECTION 28 - WELL CASING WELDED SHUT DURING INSPECTION, THUS NOT IN USE AT THIS TIME.

NEW WELL #1 IS 2013 FEET SOUTH AND 26 FEET EAST FROM THE NE COR OF SECTION 28.

WELL #2 IS 1500 FEET SOUTH AND 70 FEET WEST FROM THE NW COR DLC 44.

JOHN BORDEN CONSULTING
5597 RIVER STREET
WEST LINN, OR. 97068
503-723-4257

Roth Claim of Beneficial Use Map

FILE PATH & NAME: x:\ROTH\ROTH COBU 011015.dwg