


Quarter 1/4
or. Sec. 31

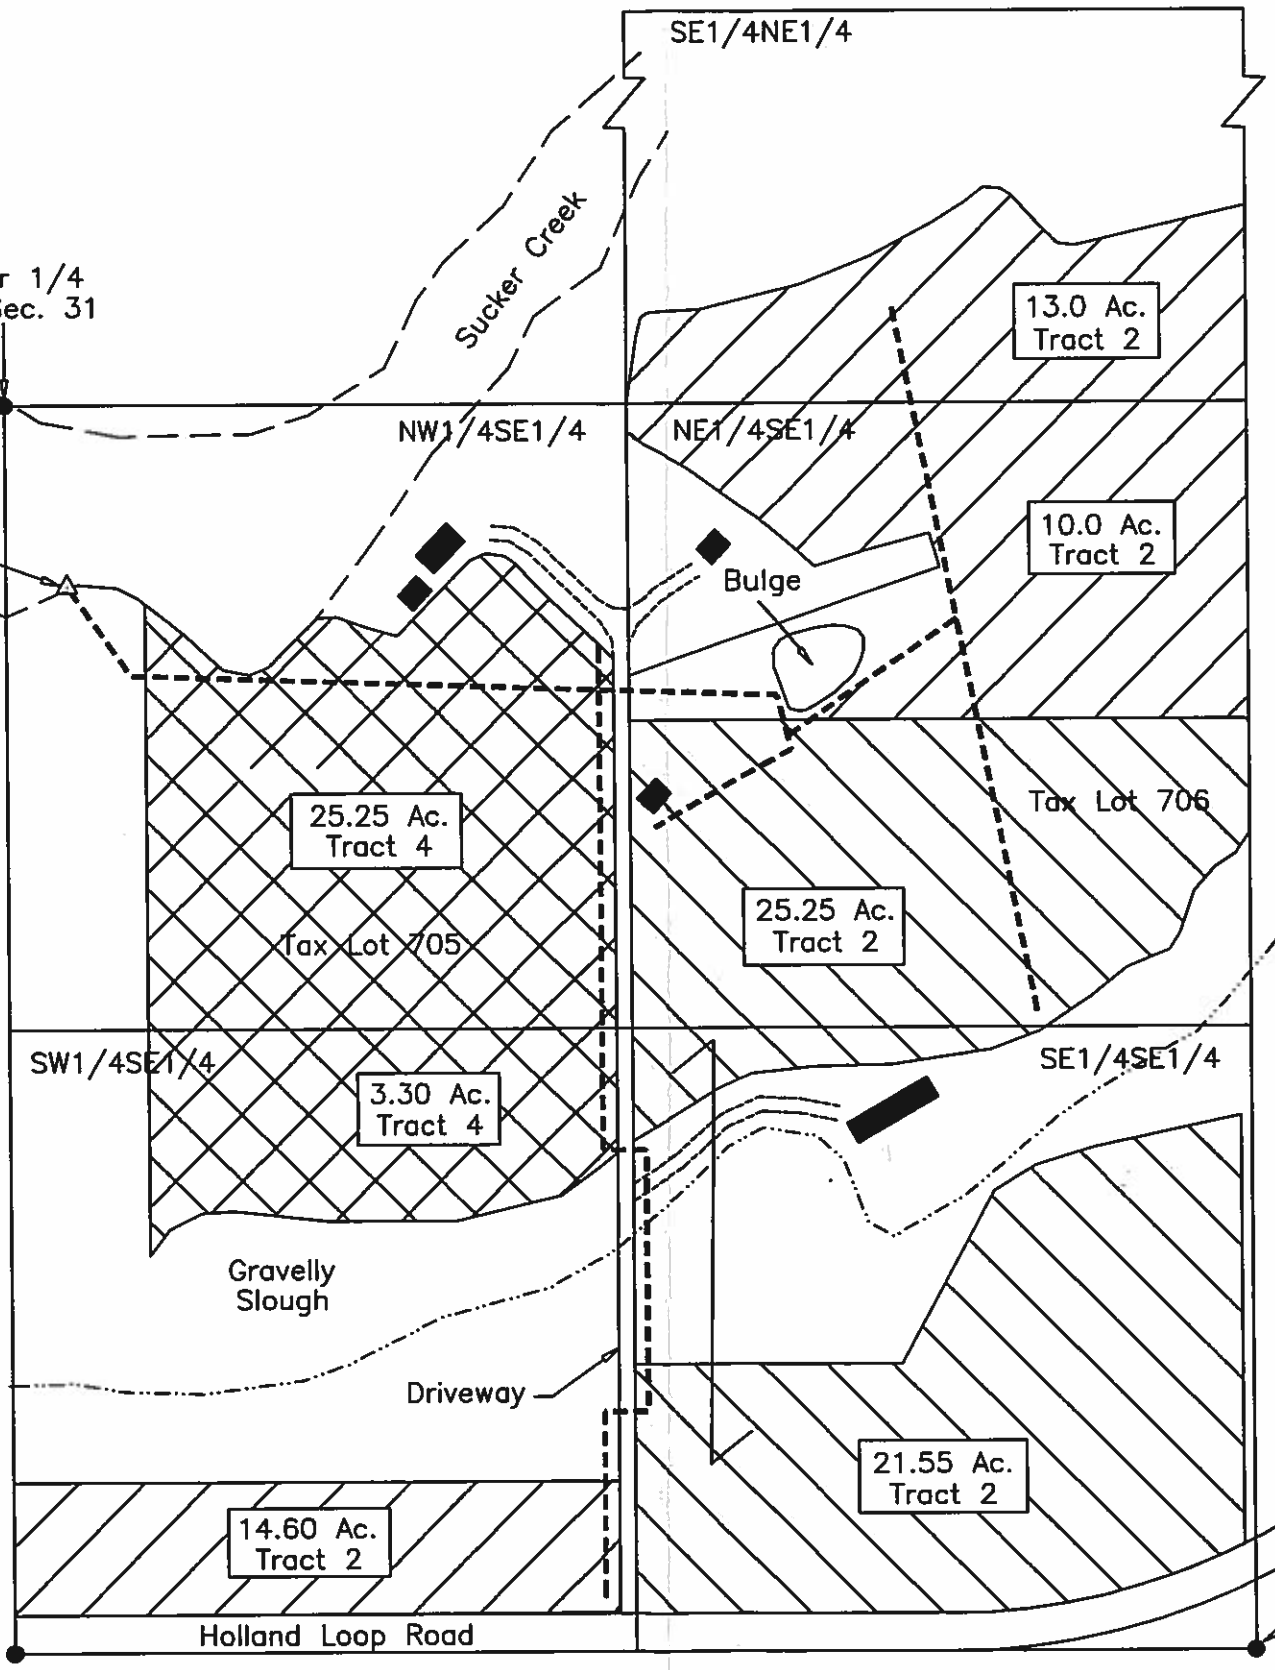

SE1/4NE1/4

Sucker Creek

13.0 Ac.
Tract 2

NW1/4SE1/4

NE1/4SE1/4

10.0 Ac.
Tract 2

Bulge

25.25 Ac.
Tract 4

Tax Lot 706

25.25 Ac.
Tract 2

Tax Lot 705

SW1/4SE1/4

SE1/4SE1/4

3.30 Ac.
Tract 4

Gravelly
Slough

Driveway

21.55 Ac.
Tract 2

14.60 Ac.
Tract 2

Holland Loop Road