


T. 1 S. R. 3 W. W. M.

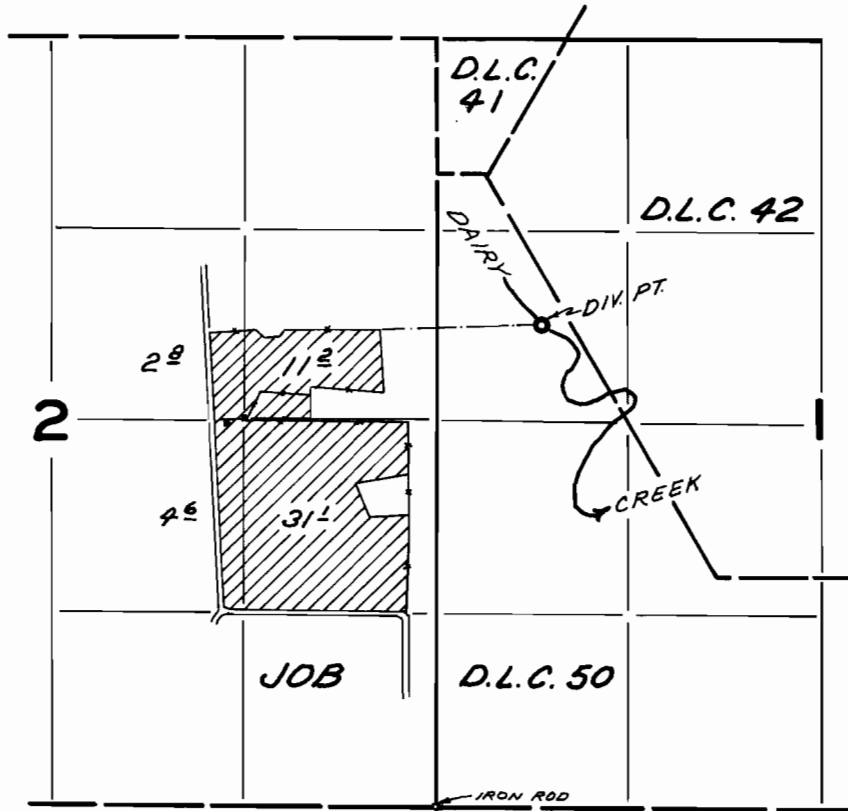


FINAL PROOF SURVEY
UNDER

Application No. 29775 Permit No. 23505
IN NAME OF


GERALD VAN DYKE

Surveyed MAY 29 1959, by R. JACKSON

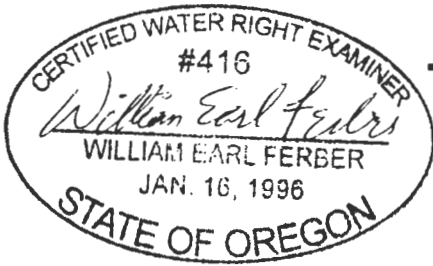

**Transfer of C 34966
for Van Dyke
T.I.S.R.3W.W.M.**

EXPIRES: 2/17.12.31

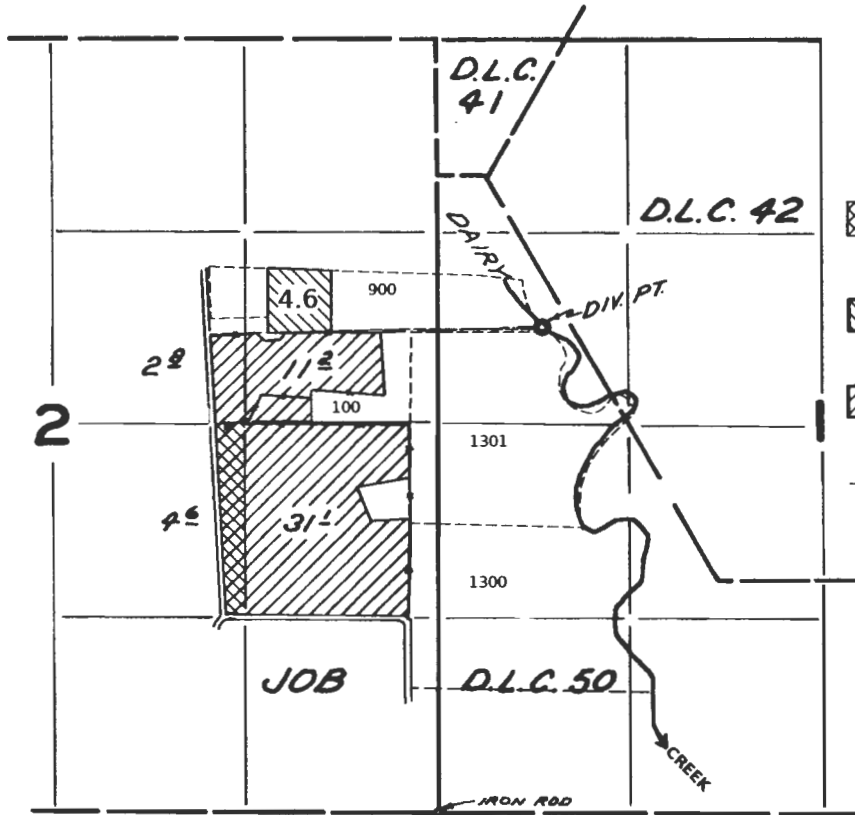

- Legend**
- From acres - C 34966
 - To acres - C 34966
 - Acres not affected by this transfer
 - Tax lot boundary

Scale: 1"=1320'

**FINAL PROOF SURVEY
UNDER**

RECEIVED BY OWRD

Application No. 29775 Permit No. 23505
IN NAME OF

APR 06 2017

GERALD VAN DYKE

SALEM, OR

Surveyed MAY 29 1959, by R. JACKSON

PREPARATION OF THIS MAP IS FOR THE PURPOSE OF IDENTIFYING THE LOCATION OF THE WATER RIGHT ONLY. THERE IS NO INTENT TO PROVIDE DIMENSIONS OR LOCATION OF PROPERTY OWNERSHIP LINES.

T 12634