


Transfer of C 35191 for Van Dyke

T.1 S.R.3 W.W.M.

EXPIRES: 2/17/12 31

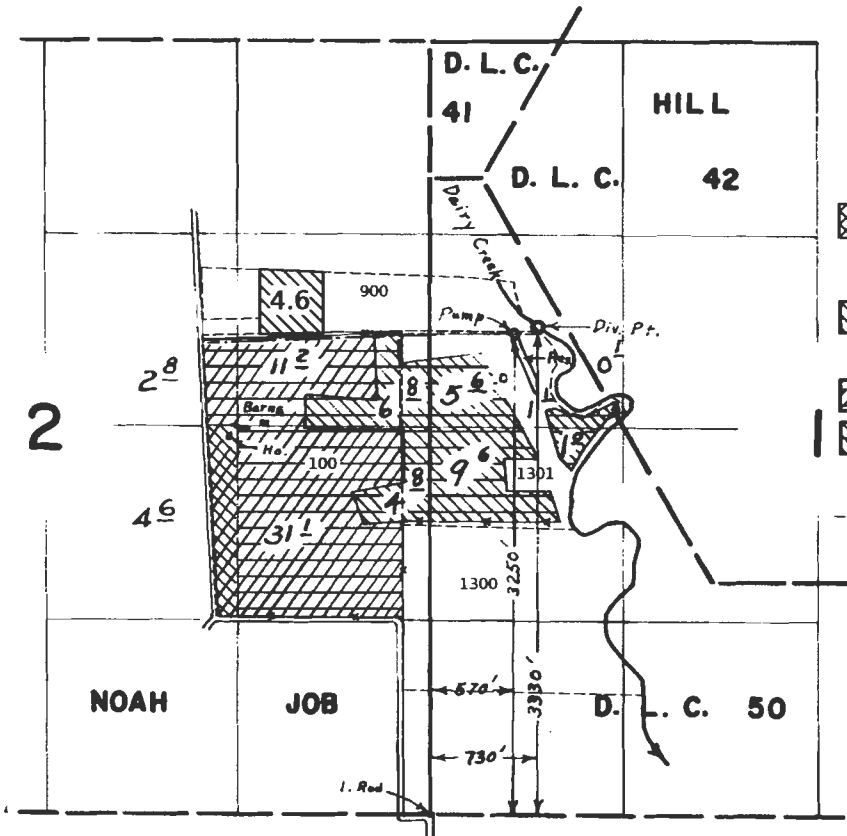

- Legend
- From acres - C 35191
 - To acres - C 35191
 - Acres not affected by this transfer
 - Tax lot boundary

Scale: 1"=1320'

FINAL PROOF SURVEY UNDER

R-41992 R-4809
Application No. 41993 Permit No. 31708
IN NAME OF

GERALD VAN DYKE

Surveyed Sept. 11, 1967, by L. E. Gould

RECEIVED BY OWRD

APR 06 2017

SALEM, OR

T 12634

PREPARATION OF THIS MAP IS FOR THE PURPOSE OF IDENTIFYING THE LOCATION OF THE WATER RIGHT ONLY. THERE IS NO INTENT TO PROVIDE DIMENSIONS OR LOCATION OF PROPERTY OWNERSHIP LINES.