


T. 26 S., R. 31 E., W.M.

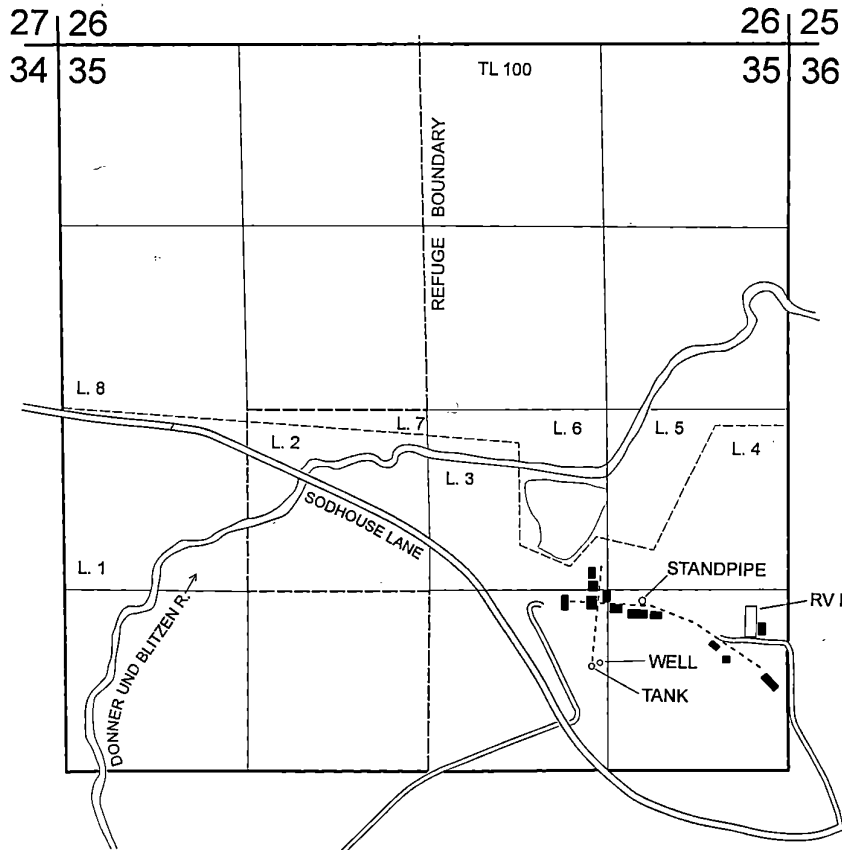

1 INCH = 1320 FEET

^{790 ALB}
 WELL IS LOCATED 620 FT NORTH AND
 1385 FT WEST FROM THE SE CORNER
 OF SECTION 35, BEING WITHIN THE
 SW 1/4 SE 1/4 OF SECTION 35.

RECEIVED
 JUL 23 2018
 OWRD

RECEIVED
 OCT 22 2018

WATER RESOURCES DEPT
 SALEM, OREGON


FINAL PROOF SURVEY

UNDER

Application No. G-15768 Permit No. G-15410

IN THE NAME OF

U.S. FISH & WILDLIFE SERVICE
 (MALHEUR NWR HEADQUARTERS)

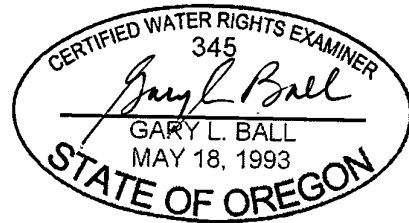

RENEWALS: 12/31/2009

This map is not intended to provide
 legal dimensions or locations of
 property ownership lines.